


1 LOCATION OF WATER WELL: County: Russell Fraction NE 1/4 SE 1/4 NE 1/4 Section Number 3 Township Number T 14 S Range Number R 14 EW

Distance and direction from nearest town or city street address of well if located within city? 1326 S. Fossil, Russell, Kansas

2 WATER WELL OWNER: I-70 Conoco RR#, St. Address, Box #: Box 153 City, State, ZIP Code: Russell, Kansas 67668 Board of Agriculture, Division of Water Resources Application Number:

3 LOCATE WELL'S LOCATION WITH AN "X" IN SECTION BOX:

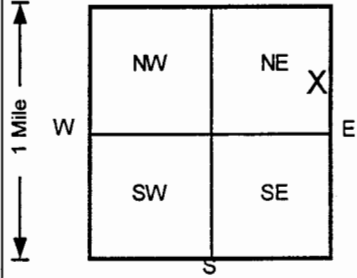

4 DEPTH OF COMPLETED WELL: 22 ft ELEVATION: 1823.8

Depth(s) Groundwater Encountered: 1. ft 2. ft 3. ft WELL'S STATIC WATER LEVEL: 15.16 ft below land surface measured on 11/18/98. Pump test data: Well water was NA ft after NA hours pumping NA gpm Est Yield NA gpm: Well water was NA ft after NA hours pumping NA gpm Bore Hole Diameter: 8 in. to 22 ft, and in. to ft. WELL WATER TO BE USED AS: 5 Public water supply 8 Air conditioning 11 Injection well 1 Domestic 3 Feedlot 6 Oil field water supply 9 Dewatering 12 Other (Specify below) 2 Irrigation 4 Industrial 7 Lawn and garden only 10 Monitoring well Was a chemical/bacteriological sample submitted to Department? Yes.....No.....; If yes, mo/day/yr sample was submitted Water Well Disinfected? Yes No

5 TYPE OF BLANK CASING USED: 1 Steel 3 RMP (SR) 5 Wrought iron 8 Concrete tile CASING JOINTS: Glued Clamped 2 PVC 4 ABS 7 Fiberglass 9 Other (specify below) Welded Threaded

Blank casing diameter: 2 in. to 12 ft, Dia in. to ft, Dia in. to ft. Casing height above land surface: -3.6 in., weight Sch 40 lbs./ft. Wall thickness or gauge No.

TYPE OF SCREEN OR PERFORATION MATERIAL: 1 Steel 3 Stainless steel 5 Fiberglass 7 PVC 10 Asbestos-cement 2 Brass 4 Galvanized steel 6 Concrete tile 8 RMP (SR) 11 Other (specify) 12 None used (open hole)

SCREEN OR PERFORATION OPENINGS ARE: 1 Continuous slot 2 Louvered shutter 3 Mill slot 4 Key punched 5 Gauzed wrapped 6 Wire wrapped 7 Torch cut 8 Saw cut 9 Drilled holes 11 None (open hole) 10 Other (specify)

SCREEN-PERFORATED INTERVALS: From 12 ft to 22 ft, From ft to ft, From ft to ft, From ft to ft GRAVEL PACK INTERVALS: From 10 ft to 22 ft, From ft to ft, From ft to ft, From ft to ft

6 GROUT MATERIAL: 1 Neat cement 2 Cement grout 3 Bentonite 4 Other Grout intervals: From 0 ft to 8 ft, From 8 ft to 10 ft, From ft to ft

What is the nearest source of possible contamination: 1 Septic tank 4 Lateral lines 7 Pit privy 10 Livestock pens 14 Abandoned water well 2 Sewer lines 5 Cess pool 8 Sewage lagoon 11 Fuel storage 15 Oil well/Gas well 3 Watertight sewer lines 6 Seepage pit 9 Feedyard 12 Fertilizer storage 16 Other (specify below) 13 Insecticide storage Tank Basin Direction from well? East How many feet? 80

Table with columns FROM, TO, LITHOLOGIC LOG, FROM, TO, PLUGGING INTERVALS. Rows include Gravel, Clay, Brown, Clay, Red Brown, Clay, Brown, Clay, Light Brown.

7 CONTRACTOR'S OR LANDOWNER'S CERTIFICATION: This water well was (1) constructed, (2) reconstructed, or (3) plugged under my jurisdiction and was completed on 11/10/98 and this record is true to the best of my knowledge and belief. Kansas Water Well Contractor's License No. 527 This Water Well Record was completed on 11/23/98 under the business name of GeoCore Services, Inc. by (signature) GeoCore