


1 LOCATION OF WATER WELL: County: Russell Fraction: NE 1/4 SE 1/4 NE 1/4 Section Number: 3 Township Number: T 14 S Range Number: R 14 E/W

Distance and direction from nearest town or city street address of well if located within city? 1326 S. Fossil, Russell, Kansas

2 WATER WELL OWNER: I-70 Conoco RR#, St. Address, Box #: Box 153 City, State, ZIP Code: Russell, Kansas 67668 Board of Agriculture, Division of Water Resources Application Number:

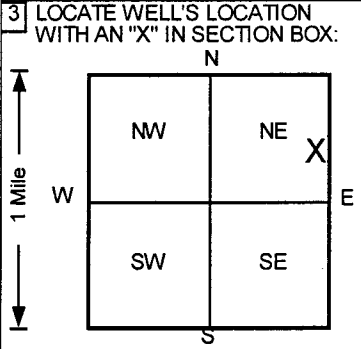

3 LOCATE WELL'S LOCATION WITH AN "X" IN SECTION BOX: 4 DEPTH OF COMPLETED WELL: 30 ft. ELEVATION: 1825.43. WELL'S STATIC WATER LEVEL: 16.86 ft. below land surface measured on 11/18/98. Pump test data: Well water was NA ft. after hours pumping. Est. Yield NA gpm. Bore Hole Diameter 8 in. to 30 ft. WELL WATER TO BE USED AS: 10 Monitoring well. Was a chemical/bacteriological sample submitted? Yes. Water Well Disinfected? Yes.

5 TYPE OF BLANK CASING USED: 2 PVC. Blank casing diameter 2 in. to 15 ft. Dia. Casing height above land surface 5.52 in., weight Sch 40. TYPE OF SCREEN OR PERFORATION MATERIAL: 7 PVC. SCREEN OR PERFORATION OPENINGS ARE: 3 Mill slot. SCREEN-PERFORATED INTERVALS: From 15 ft to 30 ft. GRAVEL PACK INTERVALS: From 13 ft to 30 ft.

6 GROUT MATERIAL: 2 Cement grout, 3 Bentonite. Grout Intervals: From 0 ft to 11 ft, From 11 ft to 13 ft. What is the nearest source of possible contamination: 16 Other (specify below) Tank Basin. Direction from well? next to

Table with columns: FROM, TO, LITHOLOGIC LOG, FROM, TO, PLUGGING INTERVALS. Rows: 0-10 Sand, Brown; 10-13 Clay, Gray; 13-30 Sand, Gray. Includes well info: MW1, Tag # 00280356, Flushmount; Project Name: I-70 Conoco; GeoCore # 683, KDHE # U6 084 4833.

7 CONTRACTOR'S OR LANDOWNER'S CERTIFICATION: This water well was (1) constructed, (2) reconstructed, or (3) plugged under my jurisdiction and was completed on (mo/day/year) 11/9/98 and this record is true to the best of my knowledge and belief. Kansas Water Well Contractor's License No. 527. This Water Well Record was completed on (mo/day/yr) 11/23/98 under the business name of GeoCore Services, Inc. by (signature) Dave Kelly.

INSTRUCTIONS: Use typewriter or ball point pen. PLEASE PRESS FIRMLY and PRINT clearly. Please fill in blanks, underline or circle the correct answers. Send top three copies to Kansas Department of Health and Environment, Bureau of Water, Topeka, Kansas 66620-0001. Telephone: 913-296-5545. Send one to WATER WELL OWNER and retain one for your records.