

**CORRECTION(S) TO WATER WELL RECORD (Form WWC-5)**

(to rectify lacking or incorrect information)

<b>LOCATION OF WATER WELL:</b> County: <u>Russell</u>	<b>Fraction</b> <u>NE</u> ¼ <u>SW</u> ¼ <u>NE</u> ¼ <u>NE</u> ¼	<b>Section</b> <u>3</u>	<b>Township</b> T <u>14</u> S	<b>Range</b> R <u>14</u> <input type="checkbox"/> E <input checked="" type="checkbox"/> W
--	--	----------------------------	----------------------------------	--

**Owner:** Leamon, Michael (was Becker, Wayne)

**Location was listed as:**

Sec. 3 T 13 S R 14 E W

Fraction:        NW NE NE

**Location changed to:**

Sec. 3 T 14 S R 14 E W

Fraction: NE SW NE NE

**Other changes:** Initial statements: Owner: Wayne Becker

Changed to: Owner: Michael Leamon

Comments: \_\_\_\_\_

Verification method: E-mail message from new owner, new well owner's address and well owner's address on WWC-5, ownership maps and directory for RussellCounty, and mapping tool and aerial photos on KGS website.

initials: DRS date: 09/22/2016


Submitted by: Kansas Geological Survey, Data Resources Library, 1930 Constant Ave., Lawrence, KS 66047-3726  
to: Kansas Dept of Health & Environment, Bureau of Water, 1000 SW Jackson, Suite 420, Topeka, KS 66612-1367.

1 LOCATION OF WATER WELL: County: Russell Fraction: NW 1/4 NE 1/4 SE 1/4 Section Number: 23 Township Number: T 13 S Range Number: R 14 E

Distance and direction from nearest town or city street address of well if located within city? 3/4

2 WATER WELL OWNER: Wayne Becker  
 RR#, St. Address, Box #: 169 E Barbara Ave  
 City, State, ZIP Code: Russell 67665  
 Board of Agriculture, Division of Water Resources  
 Application Number:

3 LOCATE WELL'S LOCATION WITH AN "X" IN SECTION BOX:

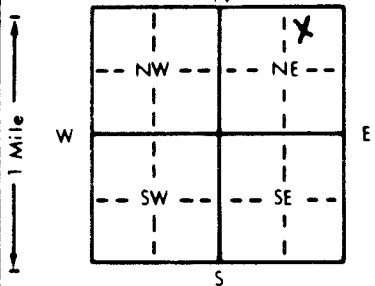

4 DEPTH OF COMPLETED WELL: 34 ft. ELEVATION: 31 ft. below land surface measured on mo/day/yr Aug 31-96

Depth(s) Groundwater Encountered 1. 34 ft. 2. 30 ft. 3. 1/2 ft.  
 WELL'S STATIC WATER LEVEL 31 ft. below land surface measured on mo/day/yr Aug 31-96  
 Pump test data: Well water was 30 ft. after 1/2 hours pumping 18 gpm  
 Est. Yield 18 gpm Well water was 47 ft. after 1/2 hours pumping 47 gpm  
 Bore Hole Diameter 8 in. to 47 ft., and 47 in. to 47 ft.  
 WELL WATER TO BE USED AS:  
 1 Domestic 3 Feedlot 6 Oil field water supply 9 Dewatering 12 Other (Specify below)  
 2 Irrigation 4 Industrial 1 Lawn and garden only 10 Monitoring well  
 Was a chemical/bacteriological sample submitted to Department? Yes X No X; If yes, mo/day/yr sample was submitted  
 Water Well Disinfected? Yes X No X

5 TYPE OF BLANK CASING USED:  
 1 Steel 3 RMP (SR) 5 Wrought iron 8 Concrete tile CASING JOINTS: Glued X Clamped X  
 2 PVC 4 ABS 6 Asbestos-Cement 9 Other (specify below) Welded X Threaded X  
 7 Fiberglass

 Casing height above land surface 12 in., weight 12 lbs./ft. Wall thickness or gauge No. SDR16

TYPE OF SCREEN OR PERFORATION MATERIAL:  
 1 Steel 3 Stainless steel 5 Fiberglass 8 RMP (SR) 10 Asbestos-cement  
 2 Brass 4 Galvanized steel 6 Concrete tile 9 ABS 11 Other (specify) 0 PVC  
 12 None used (open hole)

SCREEN OR PERFORATION OPENINGS ARE:  
 1 Continuous slot 3 Mill slot 5 Gauzed wrapped 8 Saw cut 11 None (open hole)  
 2 Louvered shutter 4 Key punched 6 Wire wrapped 9 Drilled holes  
 7 Torch cut 10 Other (specify)


6 GROUT MATERIAL: 1 Neat cement 2 Cement grout 3 Bentonite 4 Other  

What is the nearest source of possible contamination:  
 1 Septic tank 4 Lateral lines 7 Pit privy 10 Livestock pens 14 Abandoned water well  
 2 Sewer lines 5 Cess pool 8 Sewage lagoon 11 Fuel storage 15 Oil well/Gas well  
 3 Watertight sewer lines 6 Seepage pit 9 Feedyard 12 Fertilizer storage 16 Other (specify below)  
 13 Insecticide storage

Direction from well? South How many feet? 1/4 mile

FROM	TO	LITHOLOGIC LOG	FROM	TO	PLUGGING INTERVALS
0	3	Top soil			
3	33	Brown clay			
33	44	med sand			
34	47	white Rock coarse sand & gravel			

7 CONTRACTOR'S OR LANDOWNER'S CERTIFICATION: This water well was 1 constructed, 2 reconstructed, or 3 plugged under my jurisdiction and was completed on (mo/day/year) 485 Aug 31 98 and this record is true to the best of my knowledge and belief. Kansas Water Well Contractor's License No. 485 This Water Well Record was completed on (mo/day/yr) Sep-15-96 under the business name of Bushnell water well Drilling Serv by (signature) James Bushnell

INSTRUCTIONS: Use typewriter or ball point pen. PLEASE PRESS FIRMLY and PRINT clearly. Please u in blanks, underline or circle the correct answers. Send top three copies to Kansas Department of Health and Environment, Bureau of Water, Topeka, Kansas 66620-7320. Telephone: 913-296-5545. Send one to WATER WELL OWNER and retain one for your records.

OFFICE USE ONLY  
T  
R  
EW  
SEC