


1 LOCATION OF WATER WELL: County: Russell Fraction NW 1/4 SW 1/4 NW 1/4 Section Number 2 Township Number T 14 S Range Number R 14 EW

Distance and direction from nearest town or city street address of well if located within city?

U.S. Highway 281, North of I-70

2 WATER WELL OWNER: Darwin L. Sampson RR#, St. Address, Box #: 912 Barlow Dr. City, State, ZIP Code: Salina, Kansas 67401 Board of Agriculture, Division of Water Resources Application Number:

3 LOCATE WELL'S LOCATION WITH AN "X" IN SECTION BOX: [Diagram of section box with X in NW corner] 4 DEPTH OF COMPLETED WELL: 25 ft. ELEVATION: 17.04 ft. below land surface measured on mo/day/yr

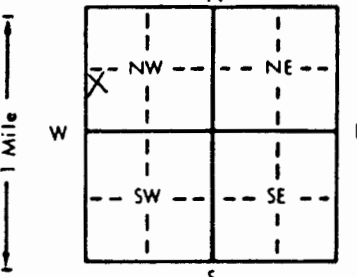

DEPTH OF COMPLETED WELL: 25 ft. ELEVATION: 17.04 ft. below land surface measured on mo/day/yr. WELL'S STATIC WATER LEVEL: 17.04 ft. below land surface measured on mo/day/yr. Pump test data: Well water was ... ft. after ... hours pumping ... gpm. Est. Yield ... gpm: Well water was ... ft. after ... hours pumping ... gpm. Bore Hole Diameter: 7 5/8 in. to 25 in. and ... in. to ... ft. WELL WATER TO BE USED AS: 5 Public water supply, 8 Air conditioning, 11 Injection well, 1 Domestic, 3 Feedlot, 6 Oil field water supply, 9 Dewatering, 12 Other (Specify below), 2 Irrigation, 4 Industrial, 7 Lawn and garden only, 10 Monitoring well. Was a chemical/bacteriological sample submitted to Department? Yes No X; If yes, mo/day/yr sample was submitted Water Well Disinfected? Yes No X

5 TYPE OF BLANK CASING USED: 1 Steel, 2 PVC, 3 RMP (SR), 4 ABS, 5 Wrought iron, 6 Asbestos-Cement, 7 Fiberglass, 8 Concrete tile, 9 Other (specify below), CASING JOINTS: Glued, Clamped, Welded, Threaded. TYPE OF SCREEN OR PERFORATION MATERIAL: 1 Steel, 2 Brass, 3 Stainless steel, 4 Galvanized steel, 5 Fiberglass, 6 Concrete tile, 7 PVC, 8 RMP (SR), 9 ABS, 10 Asbestos-cement, 11 Other (specify), 12 None used (open hole). SCREEN OR PERFORATION OPENINGS ARE: 1 Continuous slot, 2 Louvered shutter, 3 Mill slot, 4 Key punched, 5 Gauzed wrapped, 6 Wire wrapped, 7 Torch cut, 8 Saw cut, 10 Other (specify), 11 None (open hole). SCREEN-PERFORATED INTERVALS: From 10 ft. to 25 ft. GRAVEL PACK INTERVALS: From 8 ft. to 25 ft.

6 GROUT MATERIAL: 1 Neat cement, 2 Cement grout, 3 Bentonite, 4 Other. Grout Intervals: From 0 ft. to 6 ft., From 6 ft. to 8 ft. What is the nearest source of possible contamination: 1 Septic tank, 2 Sewer lines, 3 Watertight sewer lines, 4 Lateral lines, 5 Cess pool, 6 Seepage pit, 7 Pit privy, 8 Sewage lagoon, 9 Feedyard, 10 Livestock pens, 11 Fuel storage, 12 Fertilizer storage, 13 Insecticide storage, 14 Abandoned water well, 15 Oil well/Gas well, 16 Other (specify below). Direction from well? Southwest How many feet? 70

FROM	TO	LITHOLOGIC LOG	FROM	TO	PLUGGING INTERVALS
0	4"	Asphalt			
4"	4'	Cly, v drk brn, with lrg amnts of snd-grvl szd calic clsts and mod f-c snd, mod slty, damp			
4'	17'	Cly, med red brn, v slty, damp			
17'	20'	Cly, med oran-brn, mod snd-c grvl szd calic clsts, moist			
20'	25'	Cly, lt gry, v sndy, v f-med grnd, v slty			
					MW Flush Mount cover

7 CONTRACTOR'S OR LANDOWNER'S CERTIFICATION: This water well was (1) constructed, (2) reconstructed, or (3) plugged under my jurisdiction and was completed on (mo/day/year) 06-27-94 and this record is true to the best of my knowledge and belief. Kansas Water Well Contractor's License No. 527 This Water Well Record was completed on (mo/day/yr) 07-19-94 under the business name of GeoCore Services, Inc. by (signature) Darin Robt