


WATER WELL RECORD Form WWC-5 KSA 82a-1212

1 LOCATION OF WATER WELL: County: Russell	Fraction NW 1/4 SW 1/4 NW 1/4	Section Number 2	Township Number T 14 S	Range Number R 14 EW
--	--------------------------------------	-------------------------	-------------------------------	-----------------------------

Distance and direction from nearest town or city street address of well if located within city?
U.S. Highway 281, North of I-70

2 WATER WELL OWNER: **Darwin L. Sampson**
 RR#, St. Address, Box # : **912 Barlow Dr.**
 City, State, ZIP Code : **Salina, Kansas 67401**
 Board of Agriculture, Division of Water Resources
 Application Number:

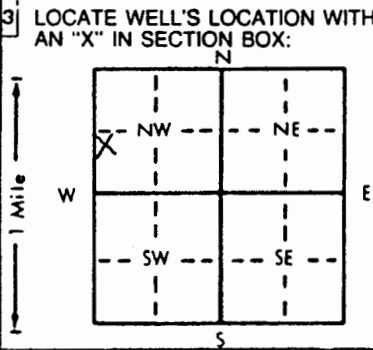

4 DEPTH OF COMPLETED WELL: **25** ft. ELEVATION: _____
 Depth(s) Groundwater Encountered 1. **25** ft. 2. _____ ft. 3. _____ ft.
 WELL'S STATIC WATER LEVEL **17.31** ft. below land surface measured on mo/day/yr
 Pump test data: Well water was _____ ft. after _____ hours pumping _____ gpm
 Est. Yield _____ gpm: Well water was _____ ft. after _____ hours pumping _____ gpm
 Bore Hole Diameter **7 5/8** in. to **25** ft., and _____ in. to _____ ft.
 WELL WATER TO BE USED AS: 5 Public water supply 8 Air conditioning 11 Injection well
 1 Domestic 3 Feedlot 6 Oil field water supply 9 Dewatering 12 Other (Specify below)
 2 Irrigation 4 Industrial 7 Lawn and garden only **10** Monitoring well
 Was a chemical/bacteriological sample submitted to Department? Yes _____ No **X** If yes, mo/day/yr sample was submitted
 Water Well Disinfected? Yes _____ No **X**

5 TYPE OF BLANK CASING USED:
 1 Steel 3 RMP (SR) 5 Wrought iron 8 Concrete tile CASING JOINTS: Glued _____ Clamped _____
2 PVC 4 ABS 6 Asbestos-Cement 9 Other (specify below) Welded _____
 7 Fiberglass _____ Threaded **X**
 Blank casing diameter **2** in. to **10** ft., Dia _____ in. to _____ ft., Dia _____ in. to _____ ft.
 Casing height above land surface **0** in., weight _____ lbs./ft. Wall thickness or gauge No. **sch 40**
 TYPE OF SCREEN OR PERFORATION MATERIAL: **7** PVC 10 Asbestos-cement
 1 Steel 3 Stainless steel 5 Fiberglass 8 RMP (SR) 11 Other (specify) _____
 2 Brass 4 Galvanized steel 6 Concrete tile 9 ABS 12 None used (open hole)
 SCREEN OR PERFORATION OPENINGS ARE:
 1 Continuous slot **3** Mill slot 5 Gauzed wrapped 8 Saw cut 11 None (open hole)
 2 Louvered shutter 4 Key punched 6 Wire wrapped 9 Drilled holes
 7 Torch cut 10 Other (specify) _____
 SCREEN-PERFORATED INTERVALS: From **10** ft. to **25** ft., From _____ ft. to _____ ft.
 From _____ ft. to _____ ft., From _____ ft. to _____ ft.
 GRAVEL PACK INTERVALS: From **8** ft. to **25** ft., From _____ ft. to _____ ft.
 From _____ ft. to _____ ft., From _____ ft. to _____ ft.

6 GROUT MATERIAL: 1 Neat cement **2** Cement grout **3** Bentonite 4 Other _____
 Grout Intervals: From **0** ft. to **6** ft., From **6** ft. to **8** ft., From _____ ft. to _____ ft.
 What is the nearest source of possible contamination:
 1 Septic tank 4 Lateral lines 7 Pit privy **11** Fuel storage 14 Abandoned water well
 2 Sewer lines 5 Cess pool 8 Sewage lagoon 12 Fertilizer storage 15 Oil well/Gas well
 3 Watertight sewer lines 6 Seepage pit 9 Feedyard 13 Insecticide storage 16 Other (specify below)
 Direction from well? _____ How many feet? _____

FROM	TO	LITHOLOGIC LOG	FROM	TO	PLUGGING INTERVALS
0	6"	Chunks of concrete and f-c snd, sl med cly, dry			
6"	2'	Cly, v drk brn with mod snd-grvl szd calic clsts, mod slty, moist			
2'	12'	Cly, med oran-brn, v slty, tr of snd szd calic, damp			
12'	17'	Alternating cly and snd seams, approx. 2"-3" in sz, mod oran-brn in clr, v slty snd, v f-f grnd, rnd-subang, moist			
17'	23'	Cly, med oran-brn, v slty, sl snd-grvl szd calic, moist			
23'	25'	Snd, lt gry-brn, v slty, v f-med grnd, sl c grns, sl-med cly			

7 CONTRACTOR'S OR LANDOWNER'S CERTIFICATION: This water well was **(1)** constructed, (2) reconstructed, or (3) plugged under my jurisdiction and was completed on (mo/day/year) **06-28-94** and this record is true to the best of my knowledge and belief. Kansas Water Well Contractor's License No. **527** This Water Well Record was completed on (mo/day/yr) **07-19-94** under the business name of **GeoCore Services, Inc** by (signature) *Dale Roll*
 MW8 Flush Mount cover

INSTRUCTIONS: Use typewriter or ball point pen. PLEASE PRESS FIRMLY and PRINT clearly. Please fill in blanks, underline or circle the correct answers. Send top three copies to Kansas Department of Health and Environment, Bureau of Water, Topeka, Kansas 66620-0001. Telephone: 913-296-5545. Send one to WATER WELL OWNER and retain one for your records.