


1 LOCATION OF WATER WELL: Fraction SE 1/4 SE 1/4 NW 1/4 Section Number 03 Township Number T 14 S Range Number R 14W E/W
 County: RUSSELL

Distance and direction from nearest town or city street address of well if located within city?
S. 281 Hiwy. E Witt Ave. Russell, Ks. 67665 Lot 15 Block 3 subd. Witt-Carter addition

2 WATER WELL OWNER: GERALD J. THOUVENELLE
 RR#, St. Address, Box #: 228 E. 14th. St.
 City, State, ZIP Code: RUSSELL, Ks. 67665
 Board of Agriculture, Division of Water Resources
 Application Number:

3 LOCATE WELL'S LOCATION WITH AN "X" IN SECTION BOX:

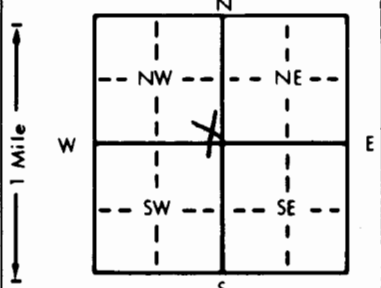

4 DEPTH OF COMPLETED WELL: 34.6 ft. ELEVATION:
 Depth(s) Groundwater Encountered: 25-30 ft. 2. 25 ft. 3. 30 ft.
 WELL'S STATIC WATER LEVEL: 23 ft. below land surface measured on mo/day/yr 7/7/90
 Pump test data: Well water was 25 ft. after 8 hours pumping 25 gpm
 Est. Yield 25 gpm: Well water was 25 ft. after 8 hours pumping 25 gpm
 Bore Hole Diameter: 7 in. to 34.6 ft., and 7 in. to 34.6 ft.
 WELL WATER TO BE USED AS:
 5 Public water supply 8 Air conditioning 11 Injection well
 1 Domestic 3 Feedlot 6 Oil field water supply 9 Dewatering 12 Other (Specify below)
 2 Irrigation 4 Industrial 7 Lawn and garden only 10 Monitoring well
 Was a chemical/bacteriological sample submitted to Department? Yes X No X; If yes, mo/day/yr sample was submitted
 Water Well Disinfected? Yes No

5 TYPE OF BLANK CASING USED:
 1 Steel 3 RMP (SR) 5 Wrought iron 8 Concrete tile CASING JOINTS: Glued Clamped
2 PVC 4 ABS 7 Fiberglass
 Casing height above land surface 12 in., weight 12 lbs./ft. Wall thickness or gauge No. 12

TYPE OF SCREEN OR PERFORATION MATERIAL:
 1 Steel 3 Stainless steel 5 Fiberglass 8 RMP (SR) 10 Asbestos-cement
 2 Brass 4 Galvanized steel 6 Concrete tile 9 ABS 11 Other (specify) 7 PVC
 12 None used (open hole)

SCREEN OR PERFORATION OPENINGS ARE:
 1 Continuous slot 3 Mill slot 5 Gauzed wrapped 8 Saw cut 11 None (open hole)
 2 Louvered shutter 4 Key punched 6 Wire wrapped 9 Drilled holes
 7 Torch cut 10 Other (specify) 24 34

SCREEN-PERFORATED INTERVALS: From 24 ft. to 34 ft., From 24 ft. to 34 ft., From 24 ft. to 34 ft., From 24 ft. to 34 ft.

GRAVEL PACK INTERVALS: From 5 ft. to 34 ft., From 5 ft. to 34 ft., From 5 ft. to 34 ft., From 5 ft. to 34 ft.

6 GROUT MATERIAL: 1 Neat cement 5 2 Cement grout 3 Bentonite 4 Other
 Grout Intervals: From 0 ft. to 5 ft., From 0 ft. to 5 ft., From 0 ft. to 5 ft., From 0 ft. to 5 ft.

What is the nearest source of possible contamination:
 1 Septic tank 4 Lateral lines 7 Pit privy 10 Livestock pens 14 Abandoned water well
 2 Sewer lines 5 Cess pool 8 Sewage lagoon 11 Fuel storage 15 Oil well/Gas well
 3 Watertight sewer lines 6 Seepage pit 9 Feedyard 12 Fertilizer storage 16 Other (specify below)
 13 Insecticide storage

Direction from well? How many feet? 200 Ft

| FROM | TO | LITHOLOGIC LOG | FROM | TO | PLUGGING INTERVALS |
|------|----|-----------------------|------|----|--------------------|
| 0 | 5 | soil | | | |
| 5 | 10 | clay | | | |
| 10 | 15 | water | | | |
| 15 | 20 | gravel | | | |
| 20 | 25 | rock | | | |
| 25 | 34 | Water stopped on rock | | | |

7 CONTRACTOR'S OR LANDOWNER'S CERTIFICATION: This water well was (1) constructed (2) reconstructed, or (3) plugged under my jurisdiction and was completed on (mo/day/year) 7/7/90 and this record is true to the best of my knowledge and belief. Kansas Water Well Contractor's License No. 521 This Water Well Record was completed on (mo/day/yr) 7/7/90 under the business name of Froelich's Drilling Serv by (signature) Jonathan Froelich