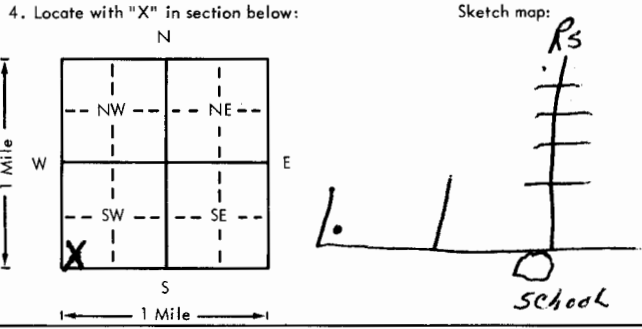


USE TYPEWRITER OR BALL POINT PEN-PRESS FIRMLY, PRINT CLEARLY.

WATER WELL RECORD  
KSA 82a-1201-1215

Kansas Department of Health and Environment-Division of Environment  
(Water well Contractors)  
Topeka, Kansas 66620

1. Location of well:	County <b>Russell</b>	Fraction <b>3/4</b> 1/4    1/4    1/4	Section number <b>21</b>	Township number T <b>14</b>	Range number S <b>R 14</b> E/W
2. Distance and direction from nearest town or city: <b>5 South of Russell 2 West.</b>			3. Owner of well: <b>Wesley Bucker</b> R.R. or street: <b>R.R.</b> City, state, zip code: <b>RUSSELL, KANSAS</b>		
4. Locate with "X" in section below: 			6. Bore hole dia. <b>8 1/2</b> in. Completion date <b>4/2/79</b> Well depth <b>141</b> ft.		
			7. <input checked="" type="checkbox"/> Cable tool <input type="checkbox"/> Rotary <input type="checkbox"/> Driven <input type="checkbox"/> Dug <input type="checkbox"/> Hollow rod <input type="checkbox"/> Jetted <input type="checkbox"/> Bored <input type="checkbox"/> Reverse rotary		
			8. Use: <input type="checkbox"/> Domestic <input type="checkbox"/> Public supply <input type="checkbox"/> Industry <input type="checkbox"/> Irrigation <input type="checkbox"/> Air conditioning <input checked="" type="checkbox"/> Stock <input type="checkbox"/> Lawn <input type="checkbox"/> Oil field water <input type="checkbox"/> Other		
			9. Casing: Material _____ Height: Above or below Threaded _____ Welded _____ Surface <b>18</b> in. RMP _____ PVC <input checked="" type="checkbox"/> Weight <b>2.83</b> lbs./ft. Dia. <b>5</b> in. to <b>141</b> ft. depth! Wall Thickness _____ inches or Dia. _____ in. to _____ ft. depth! gage No. <b>265</b>		
5. Type and color of material			10. Screen: Manufacturer's name <b>MPI</b>		
			Type <b>PVC</b> Dia. <b>5"</b>		
			Slot/gauze <b>.025</b> Length <b>10'</b>		
			Set between <b>131</b> ft. and <b>141</b> ft.		
			Gravel pack? <input checked="" type="checkbox"/> Size range of material <b>3/8 - 3/4"</b>		
			11. Static water level: _____ mo./day/yr. <b>130</b> ft. below land surface    Date <b>10-15-79</b>		
			12. Pumping level below land surfaces: _____ ft. after _____ hrs. pumping _____ g.p.m. _____ ft. after _____ hrs. pumping _____ g.p.m. Estimated maximum yield <b>2</b> g.p.m.		
			13. Water sample submitted: _____ mo./day/yr. <input type="checkbox"/> Yes <input checked="" type="checkbox"/> No    Date _____		
			14. Well head completion: <input type="checkbox"/> Pitless adapter _____ Inches above grade		
			15. Well grouted? <input checked="" type="checkbox"/> With: <input checked="" type="checkbox"/> Neat cement <input type="checkbox"/> Bentonite <input type="checkbox"/> Concrete Depth: From <b>0</b> ft. to <b>15</b> ft <b>124-134</b>		
			16. Nearest source of possible contamination: ft. _____ Direction _____ Type _____ Well disinfected upon completion? <input checked="" type="checkbox"/> Yes <input type="checkbox"/> No		
			17. Pump: <b>Windmill</b> <input type="checkbox"/> Not installed Manufacturer's name _____ Model number _____ HP _____ Volts _____ Length of drop pipe _____ ft. capacity _____ g.p.m. Type: <input type="checkbox"/> Submersible <input type="checkbox"/> Turbine <input type="checkbox"/> Jet <input type="checkbox"/> Reciprocating <input type="checkbox"/> Centrifugal <input checked="" type="checkbox"/> Other		
			(Use a second sheet if needed)		
18. Elevation:		19. Remarks:		20. Water well contractor's certification: This well was drilled under my jurisdiction and this report is true to the best of my knowledge and belief. <b>Smalls Water Well</b> <b>360</b> Business name _____ License No. _____ Address <b>95 South Kansas</b> Sign <b>William S. Wilson</b> Date <b>12/12/79</b> Authorized representative	
Topography: <input checked="" type="checkbox"/> Hill <input type="checkbox"/> Slope <input type="checkbox"/> Upland <input type="checkbox"/> Valley					

T 14 R 14 S 21 Sec 360 1/4 1/4 1/4