


1 LOCATION OF WATER WELL: County: Ellis Fraction North line Section Number 12 Township Number 14 S Range Number 17 E (W)

Distance and direction from nearest town or city street address of well if located within city?
Starting @ NWC go 2800' East along north line, (1 mile west Victoria, KS)

2 WATER WELL OWNER: Parco RR#, St. Address, Box #: PO. Box 392 City, State, ZIP Code: Plainville, KS 67663
 Test Hole to Find Shale Depth
 Board of Agriculture, Division of Water Resources Application Number:

3 LOCATE WELL'S LOCATION WITH AN "X" IN SECTION BOX:

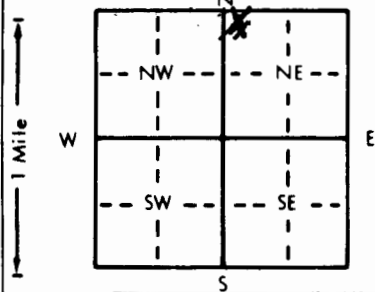

4 DEPTH OF COMPLETED WELL: NA ft. ELEVATION: NA ft.

Depth(s) Groundwater Encountered 1. NA ft. 2. NA ft. 3. NA ft.
 WELL'S STATIC WATER LEVEL NA ft. below land surface measured on mo/day/yr
 Pump test data: Well water was NA ft. after NA hours pumping NA gpm
 Est. Yield NA gpm: Well water was NA ft. after NA hours pumping NA gpm
 Bore Hole Diameter: 6" in. to 30' ft., and NA in. to NA ft.
 WELL WATER TO BE USED AS:
 5 Public water supply 8 Air conditioning 11 Injection well
 1 Domestic 3 Feedlot 6 Oil field water supply 9 Dewatering 12 Other (Specify below)
 2 Irrigation 4 Industrial 7 Lawn and garden only 10 Monitoring well test hole to find shale depth
 Was a chemical/bacteriological sample submitted to Department? Yes (No) If yes, mo/day/yr sample was submitted NA
 Water Well Disinfected? (Yes) No

5 TYPE OF BLANK CASING USED:
 1 Steel 3 RMP (SR) 5 Wrought iron 8 Concrete tile CASING JOINTS: Glued (Clamped)
 2 PVC 4 ABS 6 Asbestos-Cement 9 Other (specify below) Welded (Threaded)
 Blank casing diameter NA in. to NA ft., Dia NA in. to NA ft., Dia NA in. to NA ft.
 Casing height above land surface NA in., weight NA lbs./ft. Wall thickness or gauge No. NA
 TYPE OF SCREEN OR PERFORATION MATERIAL:
 1 Steel 3 Stainless steel 5 Fiberglass 7 PVC 10 Asbestos-cement
 2 Brass 4 Galvanized steel 6 Concrete tile 8 RMP (SR) 11 Other (specify) (None used)
 9 ABS 12 None used (open hole)
 SCREEN OR PERFORATION OPENINGS ARE:
 1 Continuous slot 3 Mill slot 5 Gauzed wrapped 8 Saw cut 11 None (open hole)
 2 Louvered shutter 4 Key punched 6 Wire wrapped 9 Drilled holes
 7 Torch cut 10 Other (specify) (None used)
 SCREEN-PERFORATED INTERVALS: From NA ft. to NA ft., From NA ft. to NA ft., From NA ft. to NA ft.
 GRAVEL PACK INTERVALS: From 30 ft. to 15 ft., From NA ft. to NA ft., From NA ft. to NA ft.

6 GROUT MATERIAL: 1 Neat cement 2 Cement grout (3) Bentonite 4 Other (None used)
 Grout Intervals: From 0 ft. to 15 ft., From NA ft. to NA ft., From NA ft. to NA ft.
 What is the nearest source of possible contamination:
 1 Septic tank 4 Lateral lines 7 Pit privy 10 Livestock pens 14 Abandoned water well
 2 Sewer lines 5 Cess pool 8 Sewage lagoon 11 Fuel storage 15 Oil well/Gas well
 3 Watertight sewer lines 6 Seepage pit 9 Feedyard 12 Fertilizer storage 16 Other (specify below) (Nothing observed)
 13 Insecticide storage

Direction from well? How many feet?

FROM	TO	LITHOLOGIC LOG	FROM	TO	PLUGGING INTERVALS
0	5 1/2	Road cover & loss	30	15	CMA gravel pack
5 1/2	8 1/2	gravel w/ clay	15	0	medium bentonite chip
8 1/2	15	brown clay			
15	19 1/2	Sch, unsorted, v. fine to gravel w/ lms. gravel			
19 1/2	21	Clay - ferruginous, brown gray			
21	25 1/2	v. fine, lms. gravel, yellow			
25 1/2	30	hard black fissile shale			

7 CONTRACTOR'S OR LANDOWNER'S CERTIFICATION: This water well was (1) constructed, (2) reconstructed, or (3) plugged under my jurisdiction and was completed on (mo/day/year) 7-4-94 and this record is true to the best of my knowledge and belief. Kansas Water Well Contractor's License No. 608 This Water Well Record was completed on (mo/day/yr) 8-2-94 under the business name of Yellow Jacket Drilling by (signature) [Signature]