


LOCATION OF WATER WELL: County: Ellis Fraction: North line Section Number: 12 Township Number: T 14 S Range Number: R 17 EW

Distance and direction from nearest town or city street address of well if located within city? Starting @ NWC go 2800' East along north line, (1 mile west Victoria, KS)

WATER WELL OWNER: Parco Test Hole to Find Shale Depth.

R#, St. Address, Box #: PO. Box 392 Board of Agriculture, Division of Water Resources
 City, State, ZIP Code: Plainville, KS 67663 Application Number:

LOCATE WELL'S LOCATION WITH AN "X" IN SECTION BOX: DEPTH OF COMPLETED WELL: NA ft. ELEVATION: NA ft.

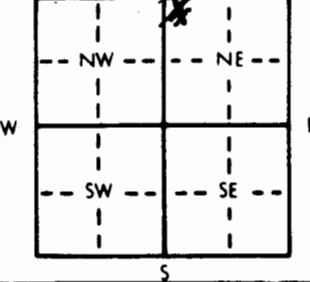

Depth(s) Groundwater Encountered: 1. NA ft. 2. NA ft. 3. NA ft.

WELL'S STATIC WATER LEVEL: NA ft. below land surface measured on mo/day/yr

Pump test data: Well water was NA ft. after NA hours pumping NA gpm

Est. Yield: NA gpm; Well water was NA ft. after NA hours pumping NA gpm

Bore Hole Diameter: 6" in. to 30' ft., and NA in. to NA ft.

WELL WATER TO BE USED AS:

5 Public water supply	8 Air conditioning	11 Injection well
1 Domestic	3 Feedlot	6 Oil field water supply
2 Irrigation	4 Industrial	7 Lawn and garden only
		9 Dewatering
		10 Monitoring well
		12 Other (Specify below)

Was a chemical/bacteriological sample submitted to Department? Yes No. If yes, mo/day/yr sample was submitted NA

Water Well Disinfected? Yes Yes No

TYPE OF BLANK CASING USED:

1 Steel	3 RMP (SR)	5 Wrought iron	8 Concrete tile	CASING JOINTS: Glued	Clamped
2 PVC	4 ABS	6 Asbestos-Cement	9 Other (specify below)	Welded	
		7 Fiberglass		Threaded	

Blank casing diameter: NA in. to NA ft., Dia. NA in. to NA ft., Dia. NA in. to NA ft.

Casing height above land surface: NA in., weight NA lbs./ft. Wall thickness or gauge No. NA

TYPE OF SCREEN OR PERFORATION MATERIAL:

1 Steel	3 Stainless steel	5 Fiberglass	8 RMP (SR)	10 Asbestos-cement	11 Other (specify)
2 Brass	4 Galvanized steel	6 Concrete tile	9 ABS	12 None used (open hole)	

SCREEN OR PERFORATION OPENINGS ARE:

1 Continuous slot	3 Mill slot	5 Gauzed wrapped	8 Saw cut	11 None (open hole)
2 Louvered shutter	4 Key punched	6 Wire wrapped	9 Drilled holes	
		7 Torch cut	10 Other (specify)	

SCREEN-PERFORATED INTERVALS: From NA ft. to NA ft., From NA ft. to NA ft., From NA ft. to NA ft.

GRAVEL PACK INTERVALS: From 30 ft. to 15 ft., From NA ft. to NA ft., From NA ft. to NA ft.

GROUT MATERIAL: 1 Neat cement 2 Cement grout 3 Bentonite 4 Other

Grout intervals: From 0 ft. to 15 ft., From NA ft. to NA ft., From NA ft. to NA ft.

What is the nearest source of possible contamination:

1 Septic tank	4 Lateral lines	7 Pit privy	10 Livestock pens	14 Abandoned water well
2 Sewer lines	5 Cess pool	8 Sewage lagoon	11 Fuel storage	15 Oil well/Gas well
3 Watertight sewer lines	6 Seepage pit	9 Feedyard	12 Fertilizer storage	16 Other (specify below)
			13 Insecticide storage	<u>Nothing Observed</u>

Direction from well? How many feet?

FROM	TO	LITHOLOGIC LOG	FROM	TO	PLUGGING INTERVALS
0	5 1/2	Road cover & loss	30	15	CMA gravel pack
5 1/2	8 1/2	gravel w/ clay	15	0	Medium bentonite chip
8 1/2	15	brown clay			
15	19 1/2	Silt, unsorted, v. fine to gravel			
19 1/2	21	clay - ferruginous, brown gray			
21	25 1/2	v. fine, lots gravel, yellow			
25 1/2	30	hard black fissile shale			

CONTRACTOR'S OR LANDOWNER'S CERTIFICATION: This water well was (1) constructed, (2) reconstructed, or (3) plugged under my jurisdiction and was completed on (mo/day/year) 7-4-94 and this record is true to the best of my knowledge and belief. Kansas Water Well Contractor's License No. 608 This Water Well Record was completed on (mo/day/yr) 8-2-94

Under the business name of Yellow Jacket Drilling by (signature) E. J. Handell

OFFICE USE ONLY
T
R
EW
SEC.