


1 LOCATION OF WATER WELL: County: Ellis	Fraction NE 1/4 NE 1/4 NW 1/4	Section Number 34	Township Number T 14 S	Range Number R 17 E/W
--	----------------------------------	----------------------	---------------------------	--------------------------

Distance and direction from nearest town or city street address of well if located within city?
3 miles south, 2 1/2 west of Victoria, Kansas

2 WATER WELL OWNER: Isidore Brull
RR#, St. Address, Box # : 2254 Butterfield Trail
City, State, ZIP Code : Victoria, Kansas 67671
Board of Agriculture, Division of Water Resources
Application Number:

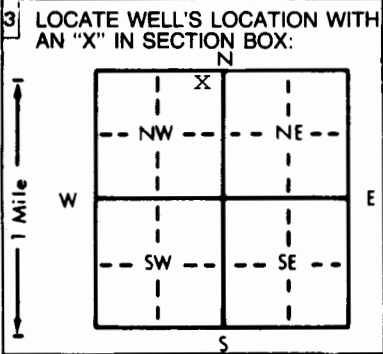

4 DEPTH OF COMPLETED WELL: 85 ft. ELEVATION: Upland
Depth(s) Groundwater Encountered 1. 58 ft. 2. . ft. 3. . ft.
WELL'S STATIC WATER LEVEL 40 ft. below land surface measured on mo/day/yr 1/3/92
Pump test data: Well water was 39 ft. after 1 hours pumping 15 gpm
Est. Yield 15 gpm: Well water was . ft. after . hours pumping . gpm
Bore Hole Diameter 10 in. to 85 ft., and . in. to . ft.
WELL WATER TO BE USED AS: 1 5 Public water supply 8 Air conditioning 11 Injection well
1 Domestic 3 Feedlot 6 Oil field water supply 9 Dewatering 12 Other (Specify below)
2 Irrigation 4 Industrial 7 Lawn and garden only 10 Monitoring well .
Was a chemical/bacteriological sample submitted to Department? Yes . No X; If yes, mo/day/yr sample was sub-
mitted Water Well Disinfected? Yes X No

5 TYPE OF BLANK CASING USED: 2 5 Wrought iron 8 Concrete tile CASING JOINTS: Glued X Clamped .
1 Steel 3 RMP (SR) 6 Asbestos-Cement 9 Other (specify below) Welded .
2 PVC 4 ABS 7 Fiberglass Threaded .
Blank casing diameter . 5 . in. to . 65 . ft., Dia . in. to . ft., Dia . in. to . ft.
Casing height above land surface . 24 . in., weight . 2.29 . lbs./ft. Wall thickness or gauge No. . 26.
TYPE OF SCREEN OR PERFORATION MATERIAL: 7 7 PVC 10 Asbestos-cement
1 Steel 3 Stainless steel 5 Fiberglass 8 RMP (SR) 11 Other (specify) .
2 Brass 4 Galvanized steel 6 Concrete tile 9 ABS 12 None used (open hole)
SCREEN OR PERFORATION OPENINGS ARE: 8 5 Gauzed wrapped 8 Saw cut 11 None (open hole)
1 Continuous slot 3 Mill slot 6 Wire wrapped 9 Drilled holes
2 Louvered shutter 4 Key punched 7 Torch cut 10 Other (specify) .
SCREEN-PERFORATED INTERVALS: From . 85 . ft. to . 65 . ft., From . ft. to . ft.
From . ft. to . ft., From . ft. to . ft.
GRAVEL PACK INTERVALS: From . 20 . ft. to . 85 . ft., From . ft. to . ft.
From . ft. to . ft., From . ft. to . ft.

6 GROUT MATERIAL: 1 1 Neat cement 2 Cement grout 3 Bentonite 4 Other .
Grout Intervals: From . 4 . ft. to . 24 . ft., From . ft. to . ft., From . ft. to . ft.
What is the nearest source of possible contamination: None 10 Livestock pens 14 Abandoned water well
1 Septic tank 4 Lateral lines 7 Pit privy 11 Fuel storage 15 Oil well/Gas well
2 Sewer lines 5 Cess pool 8 Sewage lagoon 12 Fertilizer storage 16 Other (specify below)
3 Watertight sewer lines 6 Seepage pit 9 Feedyard 13 Insecticide storage

Direction from well? How many feet?

FROM	TO	LITHOLOGIC LOG	FROM	TO	PLUGGING INTERVALS
0	3	Topsoil			
3	58	Clay			
58	78	Sand			
78	79	Clay			
79	85	Shale			

7 CONTRACTOR'S OR LANDOWNER'S CERTIFICATION: This water well was (1) constructed, (2) reconstructed, or (3) plugged under my jurisdiction and was completed on (mo/day/year) . 1/3/92 . and this record is true to the best of my knowledge and belief. Kansas Water Well Contractor's License No. . 199 . This Water Well Record was completed on (mo/day/yr) . 1/15/92 . under the business name of Karst Water Well Drilling & Service, Inc. by (signature)