


1 LOCATION OF WATER WELL: Fraction SE 1/4 SE 1/4 SE 1/4 Section Number 3 Township Number T 14 S Range Number R 18 E/W  
 County: ELLIS

Distance and direction from nearest town or city street address of well if located within city?  
2 blocks South of Canterbury St , South of Hwy 40 in Hays KS

2 WATER WELL OWNER: BILL RUPP  
 RR#, St. Address, Box # : 1300 E 19th ST Board of Agriculture, Division of Water Resources  
 City, State, ZIP Code : HAYS KS 67601 Application Number:

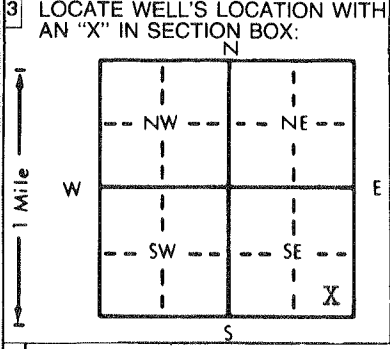

4 DEPTH OF COMPLETED WELL: 75 ft. ELEVATION: ..... ft.  
 Depth(s) Groundwater Encountered 1. 50 ft. 2. .... ft. 3. .... ft.  
 WELL'S STATIC WATER LEVEL 50 ft. below land surface measured on mo/day/yr 9-25-95  
 Pump test data: Well water was ..... ft. after ..... hours pumping ..... gpm  
 Est. Yield 60 gpm: Well water was ..... ft. after ..... hours pumping ..... gpm  
 Bore Hole Diameter 10 in. to 75 ft., and ..... in. to ..... ft.  
 WELL WATER TO BE USED AS: 5 Public water supply 8 Air conditioning 11 Injection well  
 Domestic 3 Feedlot 6 Oil field water supply 9 Dewatering 12 Other (Specify below)  
 2 Irrigation 4 Industrial 7 Lawn and garden only 10 Monitoring well .....  
 Was a chemical/bacteriological sample submitted to Department? Yes.....No ; If yes, mo/day/yr sample was submitted  
 Water Well Disinfected? Yes No

5 TYPE OF BLANK CASING USED: 5 Wrought iron 8 Concrete tile CASING JOINTS: Glued  Clamped .....  
 1 Steel 3 RMP (SR) 6 Asbestos-Cement 9 Other (specify below) Welded .....  
 PVC 4 ABS 7 Fiberglass ..... Threaded .....  
 Blank casing diameter 5 in. to 55 ft., Dia ..... in. to ..... ft., Dia ..... in. to ..... ft.  
 Casing height above land surface 20 in., weight 160 lbs./ft. Wall thickness or gauge No. ....  
 TYPE OF SCREEN OR PERFORATION MATERIAL:  PVC 10 Asbestos-cement  
 1 Steel 3 Stainless steel 5 Fiberglass 8 RMP (SR) 11 Other (specify) .....  
 2 Brass 4 Galvanized steel 6 Concrete tile 9 ABS 12 None used (open hole)  
 SCREEN OR PERFORATION OPENINGS ARE: 5 Gauzed wrapped 8 Saw cut 11 None (open hole)  
 1 Continuous slot  Mill slot 6 Wire wrapped 9 Drilled holes  
 2 Louvered shutter 4 Key punched 7 Torch cut 10 Other (specify) .....  
 SCREEN-PERFORATED INTERVALS: From 55 ft. to 75 ft., From ..... ft. to ..... ft.  
 From ..... ft. to ..... ft., From ..... ft. to ..... ft.  
 GRAVEL PACK INTERVALS: From 55 ft. to 75 ft., From ..... ft. to ..... ft.  
 From ..... ft. to ..... ft., From ..... ft. to ..... ft.

6 GROUT MATERIAL: 1 Neat cement 2 Cement grout  Bentonite 4 Other .....  
 Grout Intervals: From 0 ft. to 55 ft., From ..... ft. to ..... ft., From ..... ft. to ..... ft.  
 What is the nearest source of possible contamination:  
 1 Septic tank 4 Lateral lines 7 Pit privy 10 Livestock pens 14 Abandoned water well  
 2 Sewer lines 5 Cess pool 8 Sewage lagoon 11 Fuel storage 15 Oil well/Gas well  
 3 Watertight sewer lines 6 Seepage pit 9 Feedyard 12 Fertilizer storage 16 Other (specify below)  
 13 Insecticide storage

Direction from well? How many feet?

FROM	TO	LITHOLOGIC LOG	FROM	TO	PLUGGING INTERVALS
0	10	Surface Clay			
10	28	Hard Yellow Clays			
28	34	White Lime Stone			
34	48	Hard Gray Clays			
48	58	Med Sand			
58	68	Med to Large Sand			
68	72	Large Sand			
72	75	Blue Shale			

7 CONTRACTOR'S OR LANDOWNER'S CERTIFICATION: This water well was (1) constructed, (2) reconstructed, or (3) plugged under my jurisdiction and was completed on (mo/day/year) 9-25-95 and this record is true to the best of my knowledge and belief. Kansas Water Well Contractor's License No. 444 This Water Well Record was completed on (mo/day/yr) 9-25-95 under the business name of ANDERSON DRILLING by (signature) Andy Anderson

INSTRUCTIONS: Use typewriter or ball point pen. PLEASE PRESS FIRMLY and PRINT clearly. Please fill in blanks, underline or circle the correct answers. Send top three copies to Kansas Department of Health and Environment, Bureau of Water, Topeka, Kansas 66620-0001. Telephone: 913-296-5545. Send one to WATER WELL OWNER and retain one for your records.