


1 LOCATION OF WATER WELL: Fraction Section Number Township Number Range Number
County: Ellis SE 1/4 SE 1/4 SE 1/4 24 T 14 S R 18 EW

Distance and direction from nearest town or city street address of well if located within city?
1899 Munjor Road - Munjor, Kansas

2 WATER WELL OWNER: Ted's Tavern
RR#, St. Address, Box #: 1899 Munjor Rd. Board of Agriculture, Division of Water Resources
City, State, ZIP Code: Munjor, Kansas 67601 Application Number:

3 LOCATE WELL'S LOCATION WITH AN "X" IN SECTION BOX:
4 DEPTH OF COMPLETED WELL: 25 ft. ELEVATION: 1944.73
WELL'S STATIC WATER LEVEL: ... ft. below land surface measured on mo/day/yr
Pump test data: Well water was NA ft. after ... hours pumping ... gpm
Est. Yield: NA gpm
WELL WATER TO BE USED AS: 10 Monitoring well
Was a chemical/bacteriological sample submitted? Yes.....No[X].....; If yes, mo/day/yr sample was submitted
Water Well Disinfected? Yes No[X]

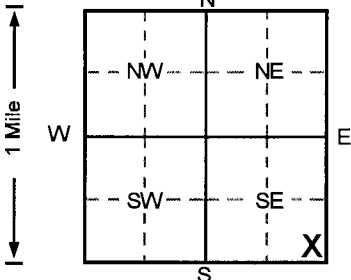

5 TYPE OF BLANK CASING USED: 1 Steel 2 PVC 3 RMP (SR) 4 ABS 5 Wrought iron 6 Asbestos-Cement 7 Fiberglass 8 Concrete tile 9 Other (specify below)
Blank casing diameter: 2 in. to 15 ft., Dia. in. to ... ft., Dia. in. to ... ft.
Casing height above land surface: -4.08 in., weight ... lbs./ft. Wall thickness or gauge No. Sch. 40
TYPE OF SCREEN OR PERFORATION MATERIAL: 7 PVC 10 Asbestos-cement
SCREEN OR PERFORATION OPENINGS ARE: 3 Mill slot
SCREEN-PERFORATED INTERVALS: From 15 ft. to 25 ft.
GRAVEL PACK INTERVALS: From 13 ft. to 25 ft.

6 GROUT MATERIAL: 2 Cement grout 3 Bentonite 4 Other
Grout Intervals: From 0 ft. to 11 ft., From 11 ft. to 13 ft., From ... ft. to ... ft.
What is the nearest source of possible contamination: 16 Other (specify below) Former UST Basin
Direction from well? 0 How many feet? 0

Table with 2 main columns: LITHOLOGIC LOG and PLUGGING INTERVALS. Rows show depth intervals and lithology: 0-2 Clay, Dark Brown; 2-8 Clay, Light Yellow Brown; 8-16.5 Clay, Brown; 16.5-20 Sand, Light Tan to Off White; 20-25 Sand, Light Tan.

7 CONTRACTOR'S OR LANDOWNER'S CERTIFICATION: This water well was (1) constructed, (2) reconstructed, or (3) plugged under my jurisdiction and was completed on (mo/day/year) 3/11/96 and this record is true to the best of my knowledge and belief.
Kansas Water Well Contractor's License No. 527 This Water Well Record was completed on (mo/day/yr) 4/2/96
under the business name of GeoCore Services, Inc. by (signature) Dale Park

INSTRUCTIONS: Use typewriter or ball point pen. PLEASE PRESS FIRMLY and PRINT clearly. Please fill in blanks, underline or circle the correct answers. Send top three copies to Kansas Department of Health and Environment, Bureau of Water, Topeka, Kansas 66620-0001. Telephone: 913-296-5545. Send one to WATER WELL OWNER and retain one for your records.

OFFICE USE ONLY
T
R
EW
SEC.
1/4
1/4
1/4