


1 LOCATION OF WATER WELL: County: Ellis Fraction SE 1/4 SE 1/4 SE 1/4 Section Number 24 Township Number T 14 S Range Number R 18 EW

Distance and direction from nearest town or city street address of well if located within city?

1899 Munjor Road - Munjor, Kansas

2 WATER WELL OWNER: Ted's Tavern RR#, St. Address, Box #: 1899 Munjor Rd. Board of Agriculture, Division of Water Resources City, State, ZIP Code: Munjor, Kansas 67601 Application Number:

3 LOCATE WELL'S LOCATION WITH AN "X" IN SECTION BOX:

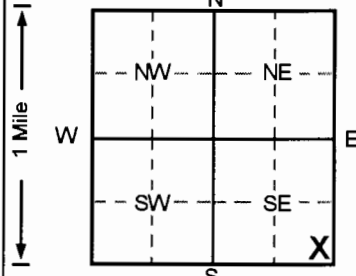

4 DEPTH OF COMPLETED WELL: 25 ft. ELEVATION: 1945.55

Depth(s) Groundwater Encountered 1... ft. 2... ft. 3... ft. WELL'S STATIC WATER LEVEL... ft. below land surface measured on mo/day/yr Pump test data: Well water was NA ft. after ... hours pumping ... gpm Est. Yield NA gpm: Well water was ... ft. after ... hours pumping ... gpm Bore Hole Diameter 8 in. to 25 ft., and ... in. to ... ft. WELL WATER TO BE USED AS: 5 Public water supply 8 Air conditioning 11 Injection well 1 Domestic 3 Feedlot 6 Oil field water supply 9 Dewatering 12 Other (Specify below) 2 Irrigation 4 Industrial 7 Lawn and garden only 10 Monitoring well Was a chemical/bacteriological sample submitted? Yes... No [checked]; If yes, mo/day/yr sample was submitted Water Well Disinfected? Yes No [checked]

5 TYPE OF BLANK CASING USED: 1 Steel 3 RMP (SR) 5 Wrought iron 8 Concrete tile CASING JOINTS: Glued ... Clamped ... 2 PVC 4 ABS 6 Asbestos-Cement 9 Other (specify below) Welded ... Threaded [checked]

Blank casing diameter 2 in. to 15 ft., Dia ... in. to ... ft., Dia ... in. to ... ft. Casing height above land surface -2.76 in., weight ... lbs./ft. Wall thickness or gauge No. Sch. 40

TYPE OF SCREEN OR PERFORATION MATERIAL: 1 Steel 3 Stainless steel 5 Fiberglass 7 PVC 10 Asbestos-cement 2 Brass 4 Galvanized steel 6 Concrete tile 8 RMP (SR) 11 Other (specify) 12 None used (open hole)

SCREEN OR PERFORATION OPENINGS ARE: 1 Continuous slot 3 Mill slot 5 Gauzed wrapped 8 Saw cut 11 None (open hole) 2 Louvered shutter 4 Key punched 6 Wire wrapped 9 Drilled holes 10 Other (specify)

SCREEN-PERFORATED INTERVALS: From 15 ft. to 25 ft., From ... ft. to ... ft. GRAVEL PACK INTERVALS: From 13 ft. to 25 ft., From ... ft. to ... ft.

6 GROUT MATERIAL: 1 Neat cement 2 Cement grout 3 Bentonite 4 Other Grout intervals: From 0 ft. to 11 ft., From 11 ft. to 13 ft., From ... ft. to ... ft.

What is the nearest source of possible contamination: 1 Septic tank 4 Lateral lines 7 Pit privy 10 Livestock pens 14 Abandoned water well 2 Sewer lines 5 Cess pool 8 Sewage lagoon 11 Fuel storage 15 Oil well/Gas well 3 Watertight sewer lines 6 Seepage pit 9 Feedyard 12 Fertilizer storage 16 Other (specify below) Former UST Basin

Direction from well? SW How many feet? 90

Table with columns: FROM, TO, LITHOLOGIC LOG, FROM, TO, PLUGGING INTERVALS. Rows: 0-0.17 Asphalt, 0.17-2 Clay, Dark Brown, 2-8 Clay, Medium Brown, 8-16 Clay, Brown, 16-22 Sand, Brown, 22-25 Sand, Brown. Additional rows for MW2, Tag # 00131812, Flushmount; Project Name: Ted's Tavern; GeoCore # 159, KDHE # U6 026 806.

7 CONTRACTOR'S OR LANDOWNER'S CERTIFICATION: This water well was (1) constructed, (2) reconstructed, or (3) plugged under my jurisdiction and was completed on (mo/day/year) 3/11/96 and this record is true to the best of my knowledge and belief. Kansas Water Well Contractor's License No. 527 This Water Well Record was completed on (mo/day/yr) 4/2/96 under the business name of GeoCore Services, Inc. by (signature) Dave Pelt

OFFICE USE ONLY

T

R

EW

SEC.

1/4

1/4

1/4