


1 LOCATION OF WATER WELL: County: Ellis Fraction: SW 1/4 SE 1/4 SW 1/4 Section Number: 2 Township Number: T 14 S Range Number: R 18 E(N)

Distance and direction from nearest town or city street address of well if located within city?
 (Backyard) 208 Northridge Drive, Hays, Kansas 67601

2 WATERWELL OWNER: Mike Larson
 RR#, St. Address, Box #: 208 Northridge Drive
 City, State, ZIP Code: Hays Kansas 67601
 Board of Agriculture, Division of Water Resources
 Application Number:

3 LOCATE WELL'S LOCATION WITH AN "X" IN SECTION BOX:
 4 DEPTH OF COMPLETED WELL: 45 ft. ELEVATION: N/A

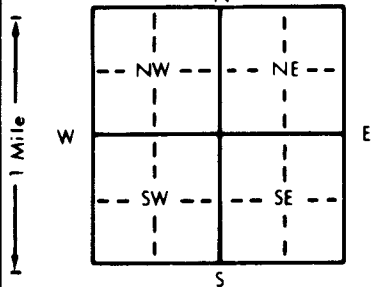

Depth(s) Groundwater Encountered 1. 30 ft. 2. _____ ft. 3. _____ ft.
 WELL'S STATIC WATER LEVEL 30 ft. below land surface measured on mo/day/yr 6-9-96
 Pump test data: Well water was 40 ft. after 30 hours pumping 3 gpm
 Est. Yield 1 1/2 gpm: Well water was _____ ft. after _____ hours pumping _____ gpm
 Bore Hole Diameter 9 in. to 45 ft. and _____ in. to _____ ft.
 WELL WATER TO BE USED AS:
 5 Public water supply 8 Air conditioning 11 Injection well
 1 Domestic 3 Feedlot 6 Oil field water supply 9 Dewatering 12 Other (Specify below)
 2 Irrigation 4 Industrial 7 Lawn and garden only 10 Monitoring well
 Was a chemical/bacteriological sample submitted to Department? Yes _____ No If yes, mo/day/yr sample was submitted _____
 Water Well Disinfected? Yes _____ No

5 TYPE OF BLANK CASING USED:
 1 Steel 3 RMP (SR) 5 Wrought iron 8 Concrete tile CASING JOINTS: Glued _____ Clamped _____
2 PVC 4 ABS 7 Fiberglass _____ Splined Centa-loK Threaded _____
 Blank casing diameter 5 in. to 33 ft. Dia _____ in. to _____ ft. Dia _____ in. to _____ ft.
 Casing height above land surface 18 in., weight _____ lbs./ft. Wall thickness or gauge No. SDR 21

TYPE OF SCREEN OR PERFORATION MATERIAL:
 1 Steel 3 Stainless steel 5 Fiberglass 8 RMP (SR) 10 Asbestos-cement
 2 Brass 4 Galvanized steel 6 Concrete tile 9 ABS 11 Other (specify) _____
 12 None used (open hole)

SCREEN OR PERFORATION OPENINGS ARE:
 1 Continuous slot 3 Mill slot 5 Gauzed wrapped 8 Saw cut 11 None (open hole)
 2 Louvered shutter 4 Key punched 6 Wire wrapped 9 Drilled holes
 7 Torch cut 10 Other (specify) _____

SCREEN-PERFORATED INTERVALS: From 45 ft. to 33 ft., From _____ ft. to _____ ft.
 From _____ ft. to _____ ft., From _____ ft. to _____ ft.
 GRAVEL PACK INTERVALS: From 45 ft. to 20 ft., From _____ ft. to _____ ft.
 From _____ ft. to _____ ft., From _____ ft. to _____ ft.

6 GROUT MATERIAL: 1 Neat cement 2 Cement grout 3 Bentonite 4 Other _____
 Grout Intervals: From 3 20 ft. to 15 ft., From 1 15 ft. to Surface ft., From _____ ft. to _____ ft.

What is the nearest source of possible contamination:
 1 Septic tank 4 Lateral lines 7 Pit privy 10 Livestock pens 14 Abandoned water well
 2 Sewer lines 5 Cess pool 8 Sewage lagoon 11 Fuel storage 15 Oil well/Gas well
3 Watertight sewer lines 6 Seepage pit 9 Feedyard 12 Fertilizer storage 16 Other (specify below) _____
 13 Insecticide storage _____

Direction from well? East How many feet? 30'

FROM	TO	LITHOLOGIC LOG	FROM	TO	PLUGGING INTERVALS
0	6	loess			
6	26	lt. brown clay			
26	27	sdly lms.			
27	30	lt. brn clay w/ intermitten v.f. grad sdly layers.			
30	36	med gr. well sorted sand			
36	37	rough - yellow lms. gravel			
37	40	degradation from sd to clay			
40	45	weathered shale			

7 CONTRACTOR'S OR LANDOWNER'S CERTIFICATION: This water well was (1) constructed, (2) reconstructed, or (3) plugged under my jurisdiction and was completed on (mo/day/year) 6-1-96 and this record is true to the best of my knowledge and belief. Kansas Water Well Contractor's License No. 608 This Water Well Record was completed on (mo/day/yr) 6-29-96 under the business name of Yellow Jacket Drilling by (signature) Eric J. Washburn