


1 LOCATION OF WATER WELL: County: **ELLIS** Fraction: **NE 1/4 SW 1/4 NW 1/4** Section Number: **12** Township Number: **T 14 S** Range Number: **R 18 EW**

Distance and direction from nearest town or city street address of well if located within city?
IN THE CITY OF HAYS KS

2 WATER WELL OWNER: **A-1 Plank & Scaffold Mfg**
 RR#, St. Address, Box #: **500 Commerce Pky** Board of Agriculture, Division of Water Resources
 City, State, ZIP Code: **Hays KS 67601** Application Number:

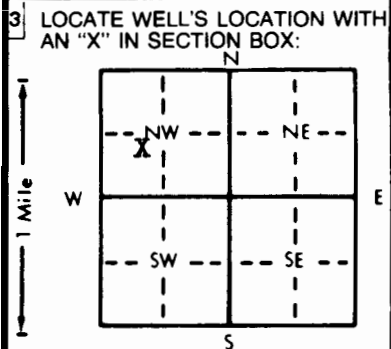

4 DEPTH OF COMPLETED WELL: **75** ft. ELEVATION:
 Depth(s) Groundwater Encountered 1. **65** ft. 2. ft. 3. ft.
 WELL'S STATIC WATER LEVEL **40** ft. below land surface measured on mo/day/yr **9-6-96**
 Pump test data: Well water was ft. after hours pumping gpm
 Est. Yield **60** gpm: Well water was ft. after hours pumping gpm
 Bore Hole Diameter: **10** in. to **75** ft., and in. to ft.
 WELL WATER TO BE USED AS: 5 Public water supply 8 Air conditioning 11 Injection well
 Domestic 3 Feedlot 6 Oil field water supply 9 Dewatering 12 Other (Specify below)
 2 Irrigation 4 Industrial 7 Lawn and garden only 10 Monitoring well
 Was a chemical/bacteriological sample submitted to Department? Yes No ; If yes, mo/day/yr sample was submitted

5 TYPE OF BLANK CASING USED:
 1 Steel 3 RMP (SR) 5 Wrought iron 8 Concrete tile CASING JOINTS: Glued Clamped
 PVC 4 ABS 6 Asbestos-Cement 9 Other (specify below) Welded
 7 Fiberglass Threaded
 Blank casing diameter: **5** in. to **55** ft., Dia in. to ft., Dia in. to ft.
 Casing height above land surface: **18** in., weight **160** lbs./ft. Wall thickness or gauge No.
 TYPE OF SCREEN OR PERFORATION MATERIAL: PVC 10 Asbestos-cement
 1 Steel 3 Stainless steel 5 Fiberglass 8 RMP (SR) 11 Other (specify)
 2 Brass 4 Galvanized steel 6 Concrete tile 9 ABS 12 None used (open hole)
 SCREEN OR PERFORATION OPENINGS ARE:
 1 Continuous slot Mill slot 5 Gauzed wrapped 8 Saw cut 11 None (open hole)
 2 Louvered shutter 4 Key punched 6 Wire wrapped 9 Drilled holes
 7 Torch cut 10 Other (specify)
 SCREEN-PERFORATED INTERVALS: From **55** ft. to **75** ft., From ft. to ft.
 GRAVEL PACK INTERVALS: From **55** **30** ft. to **75** ft., From ft. to ft.
 From ft. to ft., From ft. to ft.

6 GROUT MATERIAL: 1 Neat cement 2 Cement grout Bentonite 4 Other
 Grout Intervals: From **0** ft. to **30** ft., From ft. to ft., From ft. to ft.
 What is the nearest source of possible contamination:
 1 Septic tank 4 Lateral lines 7 Pit privy 10 Livestock pens 14 Abandoned water well
 2 Sewer lines 5 Cess pool 8 Sewage lagoon 11 Fuel storage 15 Oil well/Gas well
 3 Watertight sewer lines 6 Seepage pit 9 Feedyard 12 Fertilizer storage 16 Other (specify below)
 13 Insecticide storage
 Direction from well? How many feet?

FROM	TO	LITHOLOGIC LOG	FROM	TO	PLUGGING INTERVALS
0	10	SURFACE CLAY			
10	25	HARD YELLOW CLAY			
25	35	ROCK & CLAY			
35	55	HARD GRAY CLAY			
55	65	MED SAND			
65	72	LARGE SAND			
72	75	BLUE SHALE			

7 CONTRACTOR'S OR LANDOWNER'S CERTIFICATION: This water well was **(1)** constructed, (2) reconstructed, or (3) plugged under my jurisdiction and was completed on (mo/day/year) **9-6-96** and this record is true to the best of my knowledge and belief. Kansas Water Well Contractor's License No. **444** This Water Well Record was completed on (mo/day/yr) **9-6-96** under the business name of **ANDERSON DRILLING** by (signature) *Andy Anderson*

OFFICE USE ONLY
T
R
EW
SEC.
1/4
1/4
1/4