


1 LOCATION OF WATER WELL: Fraction NW 1/4 NW 1/4 NW 1/4 Section Number 2 Township Number T 14 S Range Number R 18 EW  
 County: Ellis

Distance and direction from nearest town or city street address of well if located within city?  
Same ASB4

2 WATER WELL OWNER: Coaches  
 RR#, St. Address, Box #: 2000 East 13th Hays, KS 67601 Board of Agriculture, Division of Water Resources  
 City, State, ZIP Code: Hays, KS 67601 Application Number:

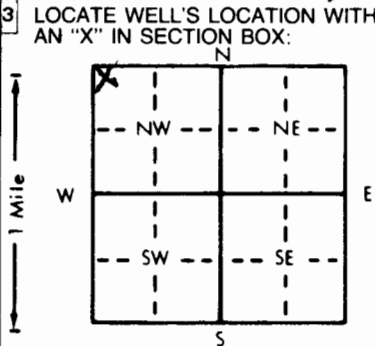

4 DEPTH OF COMPLETED WELL 38 ft. ELEVATION:  
 Depth(s) Groundwater Encountered 1. 1.24 ft. 2. 38 ft. 3. 38 ft.  
 WELL'S STATIC WATER LEVEL 1.24 ft. below land surface measured on mo/day/yr  
 Pump test data: Well water was \_\_\_\_\_ ft. after \_\_\_\_\_ hours pumping \_\_\_\_\_ gpm  
 Est. Yield \_\_\_\_\_ gpm Well water was \_\_\_\_\_ ft. after \_\_\_\_\_ hours pumping \_\_\_\_\_ gpm  
 Bore Hole Diameter 10.15 in. to 38 ft., and \_\_\_\_\_ in. to \_\_\_\_\_ ft.  
 WELL WATER TO BE USED AS:  
 1 Domestic  3 Feedlot  6 Oil field water supply  9 Dewatering   
 2 Irrigation  4 Industrial  7 Lawn and garden only  10 Monitoring well   
 5 Public water supply  8 Air conditioning  11 Injection well   
 12 Other (Specify below) Air sparge  
 Was a chemical/bacteriological sample submitted to Department? Yes \_\_\_\_\_ No ; If yes, mo/day/yr sample was sub-  
 mitted \_\_\_\_\_ Water Well Disinfected? Yes \_\_\_\_\_ No

5 TYPE OF BLANK CASING USED:  
 1 Steel  3 RMP (SR)  5 Wrought iron  8 Concrete tile  CASING JOINTS: Glued \_\_\_\_\_ Clamped \_\_\_\_\_  
 2 PVC  4 ABS  6 Asbestos-Cement  9 Other (specify below) \_\_\_\_\_ Welded \_\_\_\_\_  
 7 Fiberglass  Threaded   
 Blank casing diameter \_\_\_\_\_ in. to 36.5 ft., Dia \_\_\_\_\_ in. to \_\_\_\_\_ ft., Dia \_\_\_\_\_ in. to \_\_\_\_\_ ft.  
 Casing height above land surface \_\_\_\_\_ in., weight \_\_\_\_\_ lbs./ft. Wall thickness or gauge No. SH 80  
 TYPE OF SCREEN OR PERFORATION MATERIAL:  
 1 Steel  3 Stainless steel  5 Fiberglass  8 RMP (SR)  10 Asbestos-cement   
 2 Brass  4 Galvanized steel  6 Concrete tile  9 ABS  11 Other (specify) \_\_\_\_\_  
 12 None used (open hole)   
 SCREEN OR PERFORATION OPENINGS ARE:  
 1 Continuous slot  3 Mill slot  5 Gauzed wrapped  8 Saw cut  11 None (open hole)   
 2 Louvered shutter  4 Key punched  6 Wire wrapped  9 Drilled holes   
 7 Torch cut  10 Other (specify) \_\_\_\_\_  
 SCREEN-PERFORATED INTERVALS: From 38 ft. to 36.5 ft., From \_\_\_\_\_ ft. to \_\_\_\_\_ ft.  
 From \_\_\_\_\_ ft. to \_\_\_\_\_ ft., From \_\_\_\_\_ ft. to \_\_\_\_\_ ft.  
 GRAVEL PACK INTERVALS: From 38 ft. to 33 ft., From \_\_\_\_\_ ft. to \_\_\_\_\_ ft.  
 From \_\_\_\_\_ ft. to \_\_\_\_\_ ft., From \_\_\_\_\_ ft. to \_\_\_\_\_ ft.

6 GROUT MATERIAL: 1 Neat cement  2 Cement grout  3 Bentonite  4 Other \_\_\_\_\_  
 Grout Intervals: From 31 ft. to 0 ft., From 33 ft. to 31 ft., From \_\_\_\_\_ ft. to \_\_\_\_\_ ft.  
 What is the nearest source of possible contamination:  
 1 Septic tank  4 Lateral lines  7 Pit privy  10 Livestock pens  14 Abandoned water well   
 2 Sewer lines  5 Cess pool  8 Sewage lagoon  11 Fuel storage  15 Oil well/Gas well   
 3 Watertight sewer lines  6 Seepage pit  9 Feedyard  12 Fertilizer storage  16 Other (specify below) None  
 13 Insecticide storage \_\_\_\_\_  
 Direction from well? \_\_\_\_\_ How many feet? \_\_\_\_\_

FROM	TO	LITHOLOGIC LOG	FROM	TO	PLUGGING INTERVALS
0	2	Dark brown topsoil			
2	4	tannish red silt			
4	7	tan silt + chalk			
7	18	reddish brown silt			
18	23	FGR sand			
23	29	sandy silt			
29	38	MGR-CGR sand and gravel			

7 CONTRACTOR'S OR LANDOWNER'S CERTIFICATION: This water well was  constructed, (2) reconstructed, or (3) plugged under my jurisdiction and was completed on (mo/day/year) 10/13/95 and this record is true to the best of my knowledge and belief. Kansas Water Well Contractor's License No. 554 This Water Well Record was completed on (mo/day/yr) 3/25/97 under the business name of AGD Service by (signature) [Signature]