


1	LOCATION OF WATER WELL: See detail of this County: attached.	Fraction SE 1/4 SW 1/4 SE 1/4	Section Number 2	Township Number 14	Range Number 18W
---	--	----------------------------------	---------------------	-----------------------	---------------------

Distance and direction from nearest town or city street address of well if located within city?

2 WATER WELL OWNER: DREILING OIL INC  
1008 CODY AVE  
RR#, St. Address, Box #: Box 550  
City, State, ZIP Code: HAYS KS 67601  
Board of Agriculture, Division of Water Resources  
Application Number:

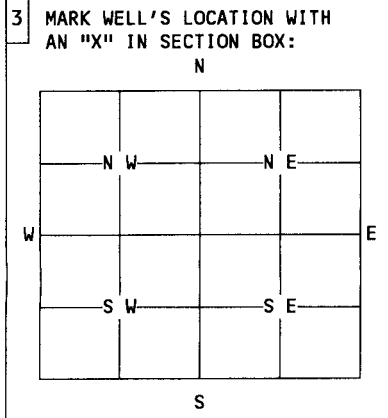

4 DEPTH OF WELL.....40.....ft.  
WELL'S STATIC WATER LEVEL.....10.....ft.  
WELL WAS USED AS:  
1 Domestic 5 Public Water Supply 9 Dewatering  
2 Irrigation 6 Oil Field Water Supply 10 Monitoring Well  
3 Feedlot 7 Lawn and Garden Only 11 Injection Well  
4 Industrial 8 Air Conditioning 12 Other.....  
Was a chemical/bacteriological sample submitted to Department? Yes....No X...  
If yes, mo/day/yr sample was submitted.....  
Water Well Disinfected: Yes..... No.....

5 TYPE OF BLANK CASING USED:  
1 Steel 3 RMP (SR) 5 Wrought 7 Fiberglass 9 Other (specify below)  
2 PVC 4 ABS 6 Asbestos-Cement 8 Concrete Tile .....  
Blank casing diameter.....in. Was casing pulled? Yes..... No..... If yes, how much.....  
Casing height above or below land surface.....in.

6 GROUT PLUG MATERIAL: 1 Neat cement 2 Cement grout 3 Bentonite 4 Other.....  
Grout Plug Intervals: From 40 ft. to 30 ft., From.....ft. to .....ft., From..... to.....ft.  
What is the nearest source of possible contamination:  
1 Septic tank 6 Seepage pit 11 Fuel storage 16 Other (specify below)  
2 Sewer lines 7 Pit privy 12 Fertilizer storage N.B. CONTAMINATION  
3 Watertight sewer lines 8 Sewage lagoon 13 Insecticide storage  
4 Lateral lines 9 Feedyard 14 Abandoned water well  
5 Cess Pool 10 Livestock pens 15 Oil well/Gas well  
Direction from well? ..... How many feet? .....

FROM	TO	PLUGGING MATERIALS	
40	10	Cement	Water Well was plugged to keep children etc from falling in at well head. No usage for well at this time.
10	0	Sand	

7 CONTRACTOR'S OR LANDOWNER'S CERTIFICATION: This water well was plugged under my jurisdiction and was completed on (mo/day/year) MAY 23, 97 and this record is true to the best of my knowledge and belief. Kansas Water Well Contractor's License No. .... This Water Well Record was completed on (mo/day/year) ..... under the business name of ..... by (signature) Joseph A. ... Ex. Vice President .....

INSTRUCTIONS: Use typewriter or ball point pen. Please press firmly and print clearly. Please fill in blanks, underline or circle the correct answers. Send top three copies to Kansas Department of Health and Environment, Bureau of Water, Topeka, Kansas 66620-0001. Telephone: 913/296-3565. Send one to Water Well Owner and retain one for your records.

A tract of land described as follows: Beginning at a point 1392 feet West and 125 feet North of the Southeast corner of Section Two (2), Township Fourteen (14) South, Range Eighteen (18) West of the 6th P.M., this being the initial point of tract; thence West 408 feet parallel to the South line of said section; thence Northerly 201 feet on a line perpendicular to the center line of the Union Pacific Railroad, to intersect the South right of way line of U.S. Highway 40; thence Easterly 400 feet along the South right of way line of U.S. Highway 40; thence Southerly approximately 150 feet along a line perpendicular to the center line of Union Pacific Railroad to the initial point of tract, containing about two (2) acres, more or less, together with the buildings and appurtenances located thereon.