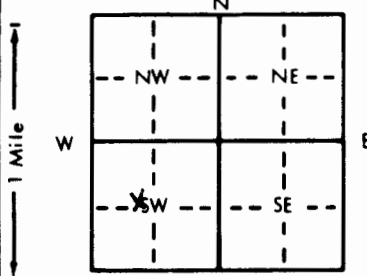


1 LOCATION OF WATER WELL: County: ELLIS Fraction: SE 1/4 NW 1/4 SW 1/4 Section Number: 2 Township Number: T 14 S Range Number: R 18 EW

Distance and direction from nearest town or city street address of well if located within city?  
1/4 mile east of intersection Canterbury and 9th Street Road, Hays, Ks. 67601

2 WATER WELL OWNER: ALLIED ASPHALT INC  
 RR#, St. Address, Box #: Box 190 Board of Agriculture, Division of Water Resources  
 City, State, ZIP Code: Hays, Ks. Application Number:

3 LOCATE WELL'S LOCATION WITH AN "X" IN SECTION BOX:  


4 DEPTH OF COMPLETED WELL: 42.0 ft. ELEVATION:  
 Depth(s) Groundwater Encountered 1. 35.0 ft. 2. ft. 3. ft.  
 WELL'S STATIC WATER LEVEL: 55.78 ft. below land surface measured on mo/day/yr 11/6/92  
 Pump test data: Well water was ft. after hours pumping gpm  
 Est. Yield gpm: Well water was ft. after hours pumping gpm  
 Bore Hole Diameter: 8.25 in. to 42.0 ft., and in. to ft.  
 WELL WATER TO BE USED AS:  
 5 Public water supply 8 Air conditioning 11 Injection well  
 1 Domestic 3 Feedlot 6 Oil field water supply 9 Dewatering 12 Other (Specify below)  
 2 Irrigation 4 Industrial 7 Lawn and garden only 10 Monitoring well MW#5  
 Was a chemical/bacteriological sample submitted to Department? Yes No X; If yes, mo/day/yr sample was submitted  
 Water Well Disinfected? Yes No X

5 TYPE OF BLANK CASING USED:  
 1 Steel 3 RMP (SR) 5 Wrought iron 8 Concrete tile CASING JOINTS: Glued Clamped  
2 PVC 4 ABS 6 Asbestos-Cement 9 Other (specify below) Welded  
 7 Fiberglass Threaded X  
 Blank casing diameter 2 in. to ft. Dia. in. to ft. Dia. in. to ft.  
 Casing height above land surface Flush Mt. in., weight 703 lbs./ft. Wall thickness or gauge No. 154  
 TYPE OF SCREEN OR PERFORATION MATERIAL:  
 1 Steel 3 Stainless steel 5 Fiberglass 8 RMP (SR) 10 Asbestos-cement  
 2 Brass 4 Galvanized steel 6 Concrete tile 9 ABS 11 Other (specify)  
 12 None used (open hole)  
 SCREEN OR PERFORATION OPENINGS ARE:  
 1 Continuous slot 3 Mill slot 5 Gauzed wrapped 8 Saw cut 11 None (open hole)  
 2 Louvered shutter 4 Key punched 6 Wire wrapped 9 Drilled holes  
 7 Torch cut 10 Other (specify)  
 SCREEN-PERFORATED INTERVALS: From 27.0 ft. to 42.0 ft., From ft. to ft.  
 GRAVEL PACK INTERVALS: From 25.0 ft. to 42.0 ft., From ft. to ft.

6 GROUT MATERIAL: 1 Neat cement 2 Cement grout 3 Bentonite 4 Other  
 Grout intervals: From 1.5 ft. to 25.0 ft., From ft. to ft., From ft. to ft.  
 What is the nearest source of possible contamination:  
 1 Septic tank 4 Lateral lines 7 Pit privy 10 Livestock pens 14 Abandoned water well  
 2 Sewer lines 5 Cess pool 8 Sewage lagoon 11 Fuel storage 15 Oil well/Gas well  
 3 Watertight sewer lines 6 Seepage pit 9 Feedyard 12 Fertilizer storage 16 Other (specify below)  
OLD TANK EXCAV.  
 Direction from well? NE How many feet? ~130'

FROM	TO	LITHOLOGIC LOG	FROM	TO	PLUGGING INTERVALS
0	.4	Asphalt Pavement			
.4	1.5	FW; CLAY, YDK GR BR, M, FIRM, GRAVELLY	28.5	35.0	TERRACE: CLAY, LT. BR, M to VM, Soft, Silty, CA concretions
1.5	3.5	LOESS; CLAY, GR BR, M, FIRM, SILTY (F)			
3.5	9.0	CLAY, R BR, M, FIRM, SILTY (L)	35.0	38.0	SILT, BR, WET, Soft, VERY SANDY
9.0	14.0	TERRACE; SILT, GR BR, MOIST, Soft, CLAYEY WITH RUST & CARBON STAINS.	38.0	42.0	SAND, BR, Used to COARSE GRAINED, POORLY GRADED WITH SILT & CLAY.
14.0	16.5	INTERBEDDED LAYERS OF SILT & SAND			
16.5	28.5	SILT, PALE BR, Sm, Soft, friable, with clay, CA concretions, carbon stains			

7 CONTRACTOR'S OR LANDOWNER'S CERTIFICATION: This water well was (1) constructed, (2) reconstructed, or (3) plugged under my jurisdiction and was completed on (mo/day/year) 11/07/92 and this record is true to the best of my knowledge and belief. Kansas Water Well Contractor's License No. 531 This Water Well Record was completed on (mo/day/yr) 11/13/92 under the business name of Geotechnical Services Inc by (signature) Dennis Hilde-Walace

OFFICE USE ONLY T R EW SEC. 1/4 1/4 1/4