


1 LOCATION OF WATER WELL: Fraction SE 1/4 NW 1/4 SW 1/4 Section Number 2 Township Number T 14 S Range Number R 18 EW
 County: ELLIS

Distance and direction from nearest town or city street address of well if located within city?
1/4 MILE east of intersection of Canterbury and 9th Street Road, Hays, Ks. 67601

2 WATER WELL OWNER: ALLIED ASPHALT Inc
 RR#, St. Address, Box #: Box 190 Board of Agriculture, Division of Water Resources
 City, State, ZIP Code: Hays, Kansas Application Number:

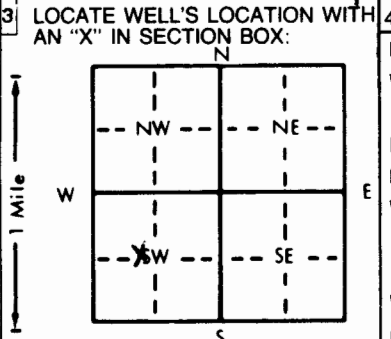

4 DEPTH OF COMPLETED WELL: 38.9 ft. ELEVATION:
 Depth(s) Groundwater Encountered 1. 31.0 ft. 2. ft. 3. ft.
 WELL'S STATIC WATER LEVEL: 33.4 ft. below land surface measured on mo/day/yr 11/6/92
 Pump test data: Well water was ft. after hours pumping gpm
 Est. Yield gpm: Well water was ft. after hours pumping gpm
 Bore Hole Diameter: 8.25 in. to 4.0 in. to in. to in. to ft.
 WELL WATER TO BE USED AS:
 5 Public water supply 8 Air conditioning 11 Injection well
 1 Domestic 3 Feedlot 6 Oil field water supply 9 Dewatering 12 Other (Specify below)
 2 Irrigation 4 Industrial 7 Lawn and garden only 10 Monitoring well MW#3
 Was a chemical/bacteriological sample submitted to Department? Yes.....No. X.....; If yes, mo/day/yr sample was submitted
 Water Well Disinfected? Yes No X

5 TYPE OF BLANK CASING USED:
 1 Steel 3 RMP (SR) 5 Wrought iron 8 Concrete tile CASING JOINTS: Glued.....Clamped.....
2 PVC 4 ABS 6 Asbestos-Cement 9 Other (specify below) Welded.....
 7 Fiberglass Threaded. X
 Blank casing diameter 2 in. to 23.9 ft., Dia. in. to in. to in. to in. to ft.
 Casing height above land surface: FLUSH MT. in., weight: 703 lbs./ft. Wall thickness or gauge No. 154
 TYPE OF SCREEN OR PERFORATION MATERIAL:
 1 Steel 3 Stainless steel 5 Fiberglass 8 RMP (SR) 10 Asbestos-cement
 2 Brass 4 Galvanized steel 6 Concrete tile 9 ABS 11 Other (specify).....
 12 None used (open hole)
 SCREEN OR PERFORATION OPENINGS ARE:
 1 Continuous slot 3 Mill slot 5 Gauzed wrapped 8 Saw cut 11 None (open hole)
 2 Louvered shutter 4 Key punched 6 Wire wrapped 9 Drilled holes
 7 Torch cut 10 Other (specify).....
 SCREEN-PERFORATED INTERVALS: From 23.9 ft. to 38.9 ft., From ft. to ft.
 From ft. to ft., From ft. to ft.
 GRAVEL PACK INTERVALS: From 21.0 ft. to 40.0 ft., From ft. to ft.
 From ft. to ft., From ft. to ft.

6 GROUT MATERIAL: 1 Neat cement 2 Cement grout 3 Bentonite 4 Other.....
 Grout intervals: From 1.5 ft. to 21.0 ft., From ft. to ft., From ft. to ft.
 What is the nearest source of possible contamination:
 1 Septic tank 4 Lateral lines 7 Pit privy 10 Livestock pens 14 Abandoned water well
 2 Sewer lines 5 Cess pool 8 Sewage lagoon 11 Fuel storage 15 Oil well/Gas well
 3 Watertight sewer lines 6 Seepage pit 9 Feedyard 12 Fertilizer storage 16 Other (specify below)
 13 Insecticide storage
 Direction from well? Northwest How many feet?

FROM	TO	LITHOLOGIC LOG	FROM	TO	PLUGGING INTERVALS
0	5	SAND PAVEMENT	31.0	35.0	SILT, Light Be, Wet, Soft, and sandy
5	3.5	FILL, CLAY, VDK BR, M, FIRM, WITH SAND & GRAVEL			
3.5	7.0	LOESS; SILT, BR, M, Soft, friable, (Peorian)	35.0	40.0	SAND, Light Be, Wet, Med, Med to coarse gr, poorly graded, Silty & clumpy
7.0	13.0	TERRACE; CLAY, GR BR, M, FIRM, Silty & Sandy			
13.0	17.5	SILT, Light red, SM, Soft CA concretions (large)			
17.5	21.0	CLAY, LT GR BR, M, FIRM WITH C STAINS & CA STRINGERS			
21.0	26.0	SILT, Light Be, SM, Soft, friable with Ca concretions			
26.0	31.0	SAME, BUT MOIST GROUNDWATER			

7 CONTRACTOR'S OR LANDOWNER'S CERTIFICATION: This water well was (1) constructed, (2) reconstructed, or (3) plugged under my jurisdiction and was completed on (mo/day/year) 11/07/92 and this record is true to the best of my knowledge and belief. Kansas Water Well Contractor's License No. 531 This Water Well Record was completed on (mo/day/yr) 11/13/92 under the business name of Geotechnical Services, Inc. by (signature) Dennis Wade Wallace

INSTRUCTIONS: Use typewriter or ball point pen. PLEASE PRESS FIRMLY and PRINT clearly. Please fill in blanks, underline or circle the correct answers. Send top three copies to Kansas Department of Health and Environment, Bureau of Water, Topeka, Kansas 66620-0001. Telephone: 913-296-5545. Send one to WATER WELL OWNER and retain one for your records.

OFFICE USE ONLY
T
R
EM
SEC
1/4
1/4
1/4