


1 LOCATION OF WATER WELL: Fraction SE 1/4 NW 1/4 SW 1/4 Section Number 2 Township Number T 14 S Range Number R 18 EW  
 County: ELLIS

Distance and direction from nearest town or city street address of well if located within city?  
1/4 mile east of intersection Canterbury & 9th Street Rd. HAYS, KS 67601

2 WATER WELL OWNER: ALLIED ASPHALT, Inc.  
 RR#, St. Address, Box #: Box 190 Board of Agriculture, Division of Water Resources  
 City, State, ZIP Code: HAYS, Ks. 67601 Application Number:

3 LOCATE WELL'S LOCATION WITH AN "X" IN SECTION BOX:

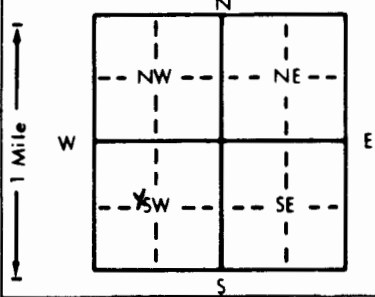

4 DEPTH OF COMPLETED WELL: 43.2 ft. ELEVATION:

Depth(s) Groundwater Encountered 1. 36.0 ft. 2. ft. 3. ft.  
 WELL'S STATIC WATER LEVEL 36.74 ft. below land surface measured on mo/day/yr 11/6/92  
 Pump test data: Well water was ft. after hours pumping gpm  
 Est. Yield gpm: Well water was ft. after hours pumping gpm  
 Bore Hole Diameter 8.25 in. to 43.2 ft., and in. to ft.  
 WELL WATER TO BE USED AS:  
 5 Public water supply 8 Air conditioning 11 Injection well  
 1 Domestic 3 Feedlot 6 Oil field water supply 9 Dewatering 12 Other (Specify below)  
 2 Irrigation 4 Industrial 7 Lawn and garden only 10 Monitoring well MW#6  
 Was a chemical/bacteriological sample submitted to Department? Yes No X; If yes, mo/day/yr sample was submitted  
 Water Well Disinfected? Yes No X

5 TYPE OF BLANK CASING USED: 5 Wrought iron 8 Concrete tile CASING JOINTS: Glued Clamped  
 1 Steel 3 RMP (SR) 6 Asbestos-Cement 9 Other (specify below) Welded  
2 PVC 4 ABS 7 Fiberglass Threaded X

Blank casing diameter 2 in. to 28.2 ft., Dia in. to ft., Dia in. to ft.  
 Casing height above land surface: 0 FLUSH MT in., weight 7.03 lbs./ft. Wall thickness or gauge No. 154

TYPE OF SCREEN OR PERFORATION MATERIAL: 7 PVC 10 Asbestos-cement  
 1 Steel 3 Stainless steel 5 Fiberglass 8 RMP (SR) 11 Other (specify)  
 2 Brass 4 Galvanized steel 6 Concrete tile 9 ABS 12 None used (open hole)

SCREEN OR PERFORATION OPENINGS ARE:  
 1 Continuous slot 3 Mill slot 5 Gauzed wrapped 8 Saw cut 11 None (open hole)  
 2 Louvered shutter 4 Key punched 6 Wire wrapped 9 Drilled holes  
 7 Torch cut 10 Other (specify)

SCREEN-PERFORATED INTERVALS: From 28.2 ft. to 43.2 ft., From ft. to ft.  
 From ft. to ft., From ft. to ft.  
 GRAVEL PACK INTERVALS: From 26.0 ft. to 43.2 ft., From ft. to ft.  
 From ft. to ft., From ft. to ft.

6 GROUT MATERIAL: 1 Neat cement 2 Cement grout 3 Bentonite 4 Other  
 Grout Intervals: From 1.5 ft. to 26.0 ft., From ft. to ft., From ft. to ft.

What is the nearest source of possible contamination:  
 1 Septic tank 4 Lateral lines 7 Pit privy 10 Livestock pens 14 Abandoned water well  
 2 Sewer lines 5 Cess pool 8 Sewage lagoon 11 Fuel storage 15 Oil well/Gas well  
 3 Watertight sewer lines 6 Seepage pit 9 Feedyard 12 Fertilizer storage 16 Other (specify below)  
OLD TANK EXCAV.  
 Direction from well? SOUTH EAST How many feet? ~100'

FROM	TO	LITHOLOGIC LOG	FROM	TO	PLUGGING INTERVALS
0	.4	ASPHALT PAVEMENT			
.4	5.0	FILL; CLAY, BLACK / DK GR, M, FIRM			
5.0	13.0	LOESS; CLAY, RBR / BR, FIRM, H, CA STRINGERS, Mg NODULES, SITY			
13.0	28.0	TERRACE; SILT, LT BR, M, SOFT, CA STRINGERS & CONCRETIONS			
28.0	32.0	CLAY, LT BR, M, FIRM, SULTY & SANDY			
32.0	43.2	SAND, BR, Med to coarse graded, poorly graded, Moist, med. ground water at 36'			

7 CONTRACTOR'S OR LANDOWNER'S CERTIFICATION: This water well was (1) constructed, (2) reconstructed, or (3) plugged under my jurisdiction and was completed on (mo/day/year) 11/7/92 and this record is true to the best of my knowledge and belief. Kansas Water Well Contractor's License No. 531 This Water Well Record was completed on (mo/day/yr) 11/13/92 under the business name of Geotechnical Services Inc by (signature) Audie Hude-Wallace