WATER WELL RECORD Form WWC-5 KSA 82a-1212

LOCATION OF WATER WELL: County: Ellis | Fraction: NW¼ NE¼ NE¼ | Section Number: 3 | Township Number: T 14 S | Range Number: R 18 E(W)

Distance and direction from nearest town or city street address of well if located within city? In Hays

WATER WELL OWNER: Dave Pilatus

RR#, St. Address, Box # : 1204 Donald Dr. | Board of Agriculture, Division of Water Resources

City, State, ZIP Code : Hays Ks | Application Number:

LOCATE WELL'S LOCATION WITH AN "X" IN SECTION BOX:

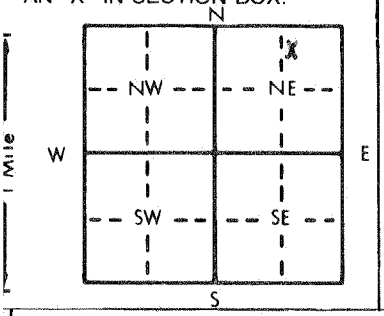

4 DEPTH OF COMPLETED WELL 41 ft. ELEVATION:

Depth(s) Groundwater Encountered 1. 31 ft. 2. ft. 3. ft.

WELL'S STATIC WATER LEVEL 30 ft. below land surface measured on mo/day/yr 3/30/85

Pump test data: Well water was ft. after hours pumping gpm

Est. Yield 10' gpm: Well water was ft. after hours pumping gpm

Bore Hole Diameter 10¼ in. to 41 ft., and in. to ft.

WELL WATER TO BE USED AS: 1 Domestic 2 Irrigation 3 Feedlot 4 Industrial 5 Public water supply 6 Oil field water supply 7 Lawn and garden only 8 Air conditioning 9 Dewatering 10 Observation well 11 Injection well 12 Other (Specify below)

Was a chemical/bacteriological sample submitted to Department? Yes No X; If yes, mo/day/yr sample was submitted

Water Well Disinfected? Yes (No)

5 TYPE OF BLANK CASING USED: 1 Steel (2 PVC) 3 RMP (SR) 4 ABS 5 Wrought iron 6 Asbestos-Cement 7 Fiberglass 8 Concrete tile 9 Other (specify below)

CASING JOINTS: Glued X Clamped Welded Threaded

Blank casing diameter 5.56 in. to 31 ft., Dia in. to ft., Dia in. to ft.

Casing height above land surface 12inches in., weight lbs./ft. Wall thickness or gauge No. SDR-26

6 TYPE OF SCREEN OR PERFORATION MATERIAL: (7 PVC)

1 Steel 2 Brass 3 Stainless steel 4 Galvanized steel 5 Fiberglass 6 Concrete tile 8 RMP (SR) 9 ABS 10 Asbestos-cement 11 Other (specify) 12 None used (open hole)

SCREEN OR PERFORATION OPENINGS ARE: 1 Continuous slot 2 Louvered shutter 3 Mill slot 4 Key punched 5 Gauzed wrapped 6 Wire wrapped 7 Torch cut (8 Saw cut) 9 Drilled holes 10 Other (specify) 11 None (open hole)

SCREEN-PERFORATED INTERVALS: From 41 ft. to 31 ft., From ft. to ft.

From ft. to ft., From ft. to ft.

GRAVEL PACK INTERVALS: From 41 ft. to 25 ft., From ft. to ft.

From ft. to ft., From ft. to ft.

7 GROUT MATERIAL: 1 Neat cement (2 Cement grout) 3 Bentonite 4 Other

Grout Intervals: From 10 ft. to 0 ft., From ft. to ft., From ft. to ft.

What is the nearest source of possible contamination:

1 Septic tank 2 Sewer lines (3 Watertight sewer lines) 4 Lateral lines 5 Cess pool 6 Seepage pit 7 Pit privy 8 Sewage lagoon 9 Feedyard 10 Livestock pens 11 Fuel storage 12 Fertilizer storage 13 Insecticide storage 14 Abandoned water well 15 Oil well/Gas well 16 Other (specify below)

Direction from well? North How many feet? 40

FROM	TO	LITHOLOGIC LOG	FROM	TO	LITHOLOGIC LOG
0	3	Top soil			
3	18	Dark Clay			
18	31	Blue Clay w/ limestone gravel w/ fine sand			
31	36	fine to medium sand			
36	41	shale			

8 CONTRACTOR'S OR LANDOWNER'S CERTIFICATION: This water well was (1) constructed (2) reconstructed, or (3) plugged under my jurisdiction and was completed on (mo/day/year) 4/1/85 and this record is true to the best of my knowledge and belief. Kansas Water Well Contractor's License No. 455 This Water Well Record was completed on (mo/day/yr) 4/18/85

under the business name of Kraus Pump & Supply by (signature) James Bieker

INSTRUCTIONS: Use typewriter or ball point pen, *PLEASE PRESS FIRMLY* and *PRINT* clearly. Please fill in blanks, underline or circle the correct answers. Send top three copies to Kansas Department of Health and Environment, Division of Environment, Environmental Geology Section, Topeka, KS 66620. Send one to WATER WELL OWNER and retain one for your records.