

LOCATION OF WATER WELL County: <u>Ellis</u>	Fraction <u>SE</u> 1/4 <u>NE</u> 1/4 <u>NE</u> 1/4	Section Number <u>3</u>	Township Number T <u>14</u> S	Range Number R <u>18</u> EW
--	---	----------------------------	----------------------------------	--------------------------------

Distance and direction from nearest town or city? \_\_\_\_\_ Street address of well if located within city?  
Canterbury Road, Hays, Kansas 67601

WATER WELL OWNER: Southwestern Bell  
 R#, St. Address, Box #: 126 West 11th  
 City, State, ZIP Code: Hays, Kansas 67601  
 Board of Agriculture, Division of Water Resources  
 Application Number: \_\_\_\_\_

DEPTH OF COMPLETED WELL: 60 ft. Bore Hole Diameter: 9 in. to \_\_\_\_\_ ft., and \_\_\_\_\_ in. to \_\_\_\_\_ ft.  
 Well Water to be used as:  
 1 Domestic 3 Feedlot 5 Public water supply 8 Air conditioning 11 Injection well  
 2 Irrigation 4 Industrial 6 Oil field water supply 9 Dewatering 12 Other (Specify below)  
 7 Lawn and garden only 10 Observation well  
 Well's static water level: 40 ft. below land surface measured on January month 9 day 1980 year  
 Pump Test Data: Well water was 40 ft. after 1 hours pumping 15 gpm  
 Test Yield: 15 gpm Well water was \_\_\_\_\_ ft. after \_\_\_\_\_ hours pumping \_\_\_\_\_ gpm


TYPE OF BLANK CASING USED:  
 1 Steel 3 RMP (SR) 5 Wrought iron 8 Concrete tile Casing Joints: Glued  Clamped \_\_\_\_\_  
 2 PVC 4 ABS 6 Asbestos-Cement 9 Other (specify below) Welded \_\_\_\_\_  
 7 Fiberglass Threaded \_\_\_\_\_  
 Blank casing dia: 5 in. to 50 ft., Dia \_\_\_\_\_ in. to \_\_\_\_\_ ft., Dia \_\_\_\_\_ in. to \_\_\_\_\_ ft.  
 Casing height above land surface: 24 in., weight \_\_\_\_\_ lbs./ft. Wall thickness or gauge No. 21

TYPE OF SCREEN OR PERFORATION MATERIAL:  
 1 Steel 3 Stainless steel 5 Fiberglass 7 PVC 10 Asbestos-cement  
 2 Brass 4 Galvanized steel 6 Concrete tile 8 RMP (SR) 11 Other (specify) \_\_\_\_\_  
 9 ABS 12 None used (open hole)  
 Screen or Perforation Openings Are:  
 1 Continuous slot 3 Mill slot 5 Gauzed wrapped 8 Saw cut 11 None (open hole)  
 2 Louvered shutter 4 Key punched 6 Wire wrapped 9 Drilled holes  
 7 Torch cut 10 Other (specify) \_\_\_\_\_  
 Screen-Perforation Dia: 5 in. to 60 ft., Dia \_\_\_\_\_ in. to \_\_\_\_\_ ft., Dia \_\_\_\_\_ in. to \_\_\_\_\_ ft.  
 Screen-Perforated Intervals: From 50 ft. to 60 ft., From \_\_\_\_\_ ft. to \_\_\_\_\_ ft., From \_\_\_\_\_ ft. to \_\_\_\_\_ ft.  
 Gravel Pack Intervals: From 40 ft. to 60 ft., From \_\_\_\_\_ ft. to \_\_\_\_\_ ft., From \_\_\_\_\_ ft. to \_\_\_\_\_ ft.

GROUT MATERIAL: 1 1 Neat cement 2 Cement grout 3 Bentonite 4 Other \_\_\_\_\_  
 Grouted Intervals: From 0 ft. to 10 ft., From \_\_\_\_\_ ft. to \_\_\_\_\_ ft., From \_\_\_\_\_ ft. to \_\_\_\_\_ ft.

What is the nearest source of possible contamination: none  
 1 Septic tank 4 Cess pool 7 Sewage lagoon 10 Fuel storage 14 Abandoned water well  
 2 Sewer lines 5 Seepage pit 8 Feed yard 11 Fertilizer storage 15 Oil well/Gas well  
 3 Lateral lines 6 Pit privy 9 Livestock pens 12 Insecticide storage 16 Other (specify below) \_\_\_\_\_  
 13 Watertight sewer lines  
 Direction from well \_\_\_\_\_ How many feet \_\_\_\_\_? Water Well Disinfected? Yes  No \_\_\_\_\_  
 Was a chemical/bacteriological sample submitted to Department? Yes \_\_\_\_\_ No  If yes, date sample submitted \_\_\_\_\_ month \_\_\_\_\_ day \_\_\_\_\_ year: Pump Installed? Yes \_\_\_\_\_ No   
 If Yes: Pump Manufacturer's name \_\_\_\_\_ Model No. \_\_\_\_\_ HP \_\_\_\_\_ Volts \_\_\_\_\_  
 Depth of Pump Intake \_\_\_\_\_ ft. Pumps Capacity rated at \_\_\_\_\_ gal./min.  
 Type of pump: 1 Submersible 2 Turbine 3 Jet 4 Centrifugal 5 Reciprocating 6 Other \_\_\_\_\_

CONTRACTOR'S OR LANDOWNER'S CERTIFICATION: This water well was (1) constructed, (2) reconstructed, or (3) plugged under my jurisdiction and was completed on January month 9 day 1980 year  
 and this record is true to the best of my knowledge and belief. Kansas Water Well Contractor's License No. 199  
 This Water Well Record was completed on January month 9 day 1981 year under the business name of Karst Water Well Service by (signature) MB Karst

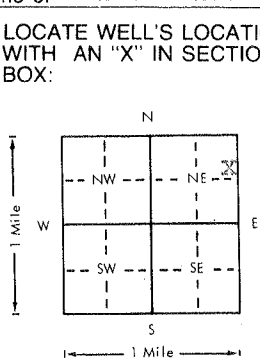

LOCATE WELL'S LOCATION WITH AN "X" IN SECTION BOX:		LITHOLOGIC LOG		LITHOLOGIC LOG	
FROM	TO		FROM	TO	
0	4	Topsoil			
4	42	Brown clay			
42	56	Sand			
56	60	Blue shale			

ELEVATION: \_\_\_\_\_  
 Depth(s) Groundwater Encountered: 1. 42 ft. 2. \_\_\_\_\_ ft. 3. \_\_\_\_\_ ft. 4. \_\_\_\_\_ ft. (Use a second sheet if needed)

INSTRUCTIONS: Use typewriter or ball point pen, please press firmly and PRINT clearly. Please fill in blanks, underline or circle the correct answers. Send top three copies to Kansas Department of Health and Environment, Division of Environment, Water Well Contractors, Topeka, KS 66620. Send one to WATER WELL OWNER and retain one for your records.