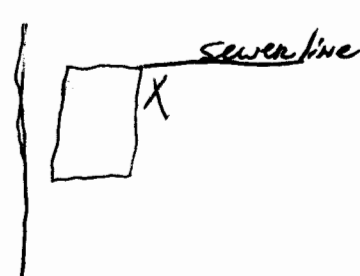


USE TYPEWRITER OR BALL POINT PEN-PRESS FIRMLY, PRINT CLEARLY.

WATER WELL RECORD
KSA 82a-1201-1215

Kansas Department of Health and Environment-Division of Environment
(Water well Contractors)
Topeka, Kansas 66620

1. Location of well: County Ellis		Fraction NW 1/4 SE 1/4 SE 1/4	Section number 3	Township number T 14 S R 18 EW 1	Range number
2. Distance and direction from nearest town or city: Street address of well location if in city: 1718 Felten Dr.			3. Owner of well: Randy Unruh R.R. or street: 1718 Felten Dr. City, state, zip code: Hays, Ks, 67601		
4. Locate with "X" in section below: N W E S 1 Mile		Sketch map: 		6. Bore hole dia. 6 in. Completion date 4-15-76 Well depth 41 ft.	
5. Type and color of material		From	To	7. <input type="checkbox"/> Cable tool <input checked="" type="checkbox"/> Rotary <input type="checkbox"/> Driven <input type="checkbox"/> Dug <input type="checkbox"/> Hollow rod <input type="checkbox"/> Jetted <input checked="" type="checkbox"/> Bored <input type="checkbox"/> Reverse rotary	
Topsoil		0	3	8. Use: <input type="checkbox"/> Domestic <input type="checkbox"/> Public supply <input type="checkbox"/> Industry <input checked="" type="checkbox"/> Irrigation <input type="checkbox"/> Air conditioning <input type="checkbox"/> Stock <input checked="" type="checkbox"/> Lawn <input type="checkbox"/> Oil field water <input type="checkbox"/> Other	
Clay		3	15	9. Casing: Material plst Height: Above or below Threaded <input type="checkbox"/> Welded gl Surface 12 in. RMP <input checked="" type="checkbox"/> PVC <input type="checkbox"/> Weight <input type="checkbox"/> lbs./ft. Dia. 5 in. to 41 ft. depth Wall Thickness: inches or Dia. <input type="checkbox"/> in. to <input type="checkbox"/> ft. depth Gauge No. 200	
Sand, dry		15	22	10. Screen: Manufacturer's name Jess + Lowell Type RMP Dia. 5 in Slot/gauze 0.06 Length 8' Set between 33 ft. and 41 ft. ft. and <input type="checkbox"/> ft. Gravel pack? yes Size range of material 1/2"	
Water Sand		22	41	11. Static water level: <input type="checkbox"/> mo./day/yr. 22 ft. below land surface Date 4-13-76	
Blue Shale		41		12. Pumping level below land surfaces: 16 ft. after 2 hrs. pumping 15 g.p.m. <input type="checkbox"/> ft. after <input type="checkbox"/> hrs. pumping <input type="checkbox"/> g.p.m. Estimated maximum yield 15 g.p.m.	
				13. Water sample submitted: <input type="checkbox"/> Yes <input checked="" type="checkbox"/> No Date <input type="checkbox"/>	
				14. Well head completion: <input type="checkbox"/> Pitless adapter 12 inches above grade	
				15. Well grouted? yes With: <input checked="" type="checkbox"/> Neat cement <input type="checkbox"/> Bentonite <input type="checkbox"/> Concrete Depth: From 0 ft. to 10 ft.	
				16. Nearest source of possible contamination: Sewer ft. 12 Direction N Type line Well disinfected upon completion? <input checked="" type="checkbox"/> Yes <input type="checkbox"/> No	
				17. Pump: <input type="checkbox"/> Not installed Manufacturer's name Fairbanks Morse Model number <input type="checkbox"/> HP 1/2 Volts 220 Length of drop pipe 39 ft. capacity 15 g.p.m. Type: <input checked="" type="checkbox"/> Submersible <input type="checkbox"/> Turbine <input type="checkbox"/> Jet <input type="checkbox"/> Reciprocating <input type="checkbox"/> Centrifugal <input type="checkbox"/> Other	
(Use a second sheet if needed)					
18. Elevation: Topography: level <input type="checkbox"/> Hill <input type="checkbox"/> Slope <input type="checkbox"/> Upland <input type="checkbox"/> Valley		19. Remarks:		20. Water well contractor's certification: This well was drilled under my jurisdiction and this report is true to the best of my knowledge and belief. R. F. Coupal 266 Business name License No. Address 616 E. 6th Hays Ks Signed Randy F Coupal Date 4-15-76 Authorized representative	

17 18 19 20
T R Sec
NW SE SE
1/4 1/4 1/4

Forward the white, blue and pink copies to the Department of Health and Environment

Form WWC-5