


LOCATION OF WATER WELL: Fraction SW 1/4 NW 1/4 SW 1/4 Section Number 3 Township Number T 14 S Range Number R 18 EW

Distance and direction from nearest town or city street address of well if located within city? Just south of 183 Hwy/south bypass - east side of Hays - (Near Standish Ford)

WATER WELL OWNER: Hays, City of Board of Agriculture, Division of Water Resources  
 RR#, St. Address, Box #: 1507 Main Application Number: VR - EL 002  
 City, State, ZIP Code: Hays, KS 67601

LOCATE WELL'S LOCATION WITH AN "X" IN SECTION BOX: DEPTH OF COMPLETED WELL: 59.5 ft. ELEVATION: unknown

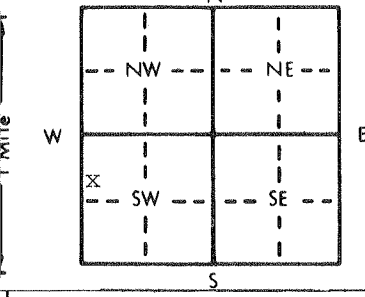

Depth(s) Groundwater Encountered 1. NA ft. 2. ft. 3. ft.  
 WELL'S STATIC WATER LEVEL: 26 ft. below land surface measured on mo/day/yr  
 Pump test data: Well water was not ch'd. ft. after hours pumping gpm  
 Est. Yield unknown gpm: Well water was ft. after hours pumping gpm  
 Bore Hole Diameter: 36 in. to 59.5 ft., and in. to ft.  
 WELL WATER TO BE USED AS:  
 5 Public water supply 8 Air conditioning 11 Injection well  
 1 Domestic 3 Feedlot 6 Oil field water supply 9 Dewatering 12 Other (Specify below)  
 2 Irrigation 4 Industrial 7 Lawn and garden only 10 Monitoring well  
 Was a chemical/bacteriological sample submitted to Department? Yes No; If yes, mo/day/yr sample was submitted  
 Water Well Disinfected? Yes X No

TYPE OF BLANK CASING USED:  
 1 Steel 3 RMP (SR) 5 Wrought iron 8 Concrete tile CASING JOINTS: Glued Clamped  
 2 PVC 4 ABS 6 Asbestos-Cement 9 Other (specify below) Welded X  
 7 Fiberglass Threaded

Blank casing diameter: 1.2 3/4 in. to 44 ft., Dia: 12 3/4 in. to 56.5 ft., Dia: in. to ft.  
 Casing height above land surface: 36 in., weight: 49.56 lbs./ft. Wall thickness or gauge No.: 37.5

TYPE OF SCREEN OR PERFORATION MATERIAL:  
 1 Steel 3 Stainless steel 5 Fiberglass 8 RMP (SR) 10 Asbestos-cement 11 Other (specify)  
 2 Brass 4 Galvanized steel 6 Concrete tile 9 ABS 12 None used (open hole)

SCREEN OR PERFORATION OPENINGS ARE:  
 1 Continuous slot 3 Mill slot 5 Gauzed wrapped 8 Saw cut 11 None (open hole)  
 2 Louvered shutter 4 Key punched 6 Wire wrapped 9 Drilled holes  
 7 Torch cut 10 Other (specify)

SCREEN-PERFORATED INTERVALS: From 44.5 ft. to 54.5 ft., From ft. to ft., From ft. to ft.  
 GRAVEL PACK INTERVALS: From 35 ft. to 57 ft., From ft. to ft., From ft. to ft.

GROUT MATERIAL: 1 Neat cement 2 Cement grout 3 Bentonite 4 Other hole plug  
 Grout Intervals: From 0 ft. to 20 ft., From ft. to ft., From ft. to ft.

What is the nearest source of possible contamination:  
 1 Septic tank 4 Lateral lines 7 Pit privy 11 Fuel storage 14 Abandoned water well  
 2 Sewer lines 5 Cess pool 8 Sewage lagoon 12 Fertilizer storage 15 Oil well/Gas well  
 3 Watertight sewer lines 6 Seepage pit 9 Feedyard 13 Insecticide storage 16 Other (specify below)  
 none known

Direction from well? How many feet?

FROM	TO	LITHOLOGIC LOG	FROM	TO	PLUGGING INTERVALS
0	5	Topsoil			
5	12	Clay, mixed with sand and gravel mixed limestone, very hard 9'-10'			
12	35	Clay, brown, silty			
35	54.5	Gravel, fine to medium, some large limestone cobble			
54.5	55	Gravel and mixed green clay			
55	57	Black Shale			
NOTE: This is an offset well - drilled 10' west and 5' south of existing PWS well.					

CONTRACTOR'S OR LANDOWNER'S CERTIFICATION: This water well was (1) constructed, (2) reconstructed, or (3) plugged under my jurisdiction and was completed on (mo/day/year) 7-20-89 and this record is true to the best of my knowledge and belief. Kansas Water Well Contractor's License No. 185. This Water Well Record was completed on (mo/day/yr) 9-15-89 under the business name of Clarke Well & Equipment, Inc. by (signature) [Signature]