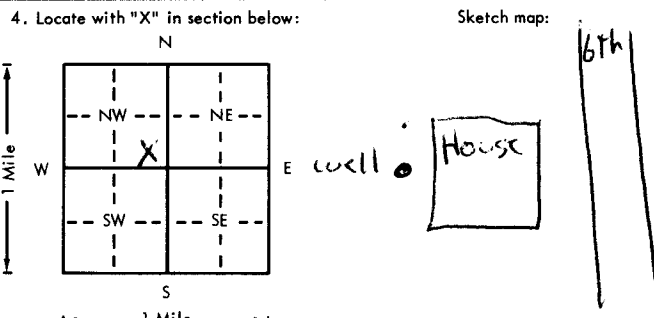


USE TYPEWRITER OR BALL POINT PEN-PRESS FIRMLY, PRINT CLEARLY.

WATER WELL RECORD
KSA 82a-1201-1215

Kansas Department of Health and Environment-Division of Environment
(Water well Contractors)
Topeka, Kansas 66620

1. Location of well: County <u>ELLIS</u> Fraction <u>SE 1/4 SE 1/4 NW 1/4</u> Section number <u>4</u> Township number <u>T 14</u> Range number <u>S R 18</u> E/W	
2. Distance and direction from nearest town or city: Street address of well location if in city: <u>310 E. 16th</u> 3. Owner of well: <u>Harold Heuser</u> R.R. or street: <u>310 E. 16th</u> City, state, zip code: <u>Hays, KS. 67601</u>	
4. Locate with "X" in section below: Sketch map: 	
5. Type and color of material	
	From To
<u>Top soil</u>	<u>0</u> <u>4</u>
<u>Yellow clay</u>	<u>4</u> <u>11</u>
<u>Fine to coarse sand</u>	<u>11</u> <u>32</u>
<u>Shale</u>	<u>32</u> <u>35</u>
6. Bore hole dia. <u>9</u> in. Completion date <u>1/5/77</u> Well depth <u>35</u> ft.	
7. <input type="checkbox"/> Cable tool <input checked="" type="checkbox"/> Rotary <input type="checkbox"/> Driven <input type="checkbox"/> Dug <input type="checkbox"/> Hollow rod <input type="checkbox"/> Jetted <input type="checkbox"/> Bored <input type="checkbox"/> Reverse rotary	
8. Use: <input type="checkbox"/> Domestic <input type="checkbox"/> Public supply <input type="checkbox"/> Industry <input type="checkbox"/> Irrigation <input type="checkbox"/> Air conditioning <input type="checkbox"/> Stock <input checked="" type="checkbox"/> Lawn <input type="checkbox"/> Oil field water <input type="checkbox"/> Other	
9. Casing: Material <u>PVC</u> Height: <u>Above</u> of below Threaded <input type="checkbox"/> Welded <input checked="" type="checkbox"/> Surface <u>76</u> in. RMP <input type="checkbox"/> PVC <input checked="" type="checkbox"/> Weight <u> </u> lbs./ft. Dia. <u>5</u> in. to <u>35</u> ft. depth; Wall Thickness: inches or Dia. <u> </u> in. to <u> </u> ft. depth; gage No. <u>162</u>	
10. Screen: Manufacturer's name <u>Jet stream</u> Type <u>perforations 10'</u> Dia. <u>5"</u> Slot/gauze <u> </u> Length <u> </u> Set between <u>25</u> ft. and <u>35</u> ft. <u> </u> ft. and <u> </u> ft. Gravel pack? <u>yes</u> Size range of material <u>1/4-1/2</u>	
11. Static water level: <u>25</u> ft. below land surface Date <u>1/5/77</u> mo./day/yr.	
12. Pumping level below land surfaces: <u>27</u> ft. after <u>1</u> hrs. pumping <u>10</u> g.p.m. <u> </u> ft. after <u> </u> hrs. pumping <u> </u> g.p.m. Estimated maximum yield <u>10</u> g.p.m.	
13. Water sample submitted: <u> </u> mo./day/yr. Yes <input type="checkbox"/> No <input checked="" type="checkbox"/> Date <u> </u>	
14. Well head completion: <input type="checkbox"/> Pitless adapter <u>16</u> inches above grade	
15. Well grouted? <u> </u> With: <input checked="" type="checkbox"/> Neat cement <input type="checkbox"/> Bentonite <input type="checkbox"/> Concrete Depth: From <u>TOP</u> ft. to <u>10</u> ft.	
16. Nearest source of possible contamination: <u>none</u> ft. <u> </u> Direction <u> </u> Type <u> </u> Well disinfected upon completion? <input checked="" type="checkbox"/> Yes <input type="checkbox"/> No	
17. Pump: <input checked="" type="checkbox"/> Not installed Manufacturer's name <u> </u> Model number <u> </u> HP <u> </u> Volts <u> </u> Length of drop pipe <u> </u> ft. capacity <u> </u> g.p.m. Type: <input type="checkbox"/> Submersible <input type="checkbox"/> Turbine <input type="checkbox"/> Jet <input type="checkbox"/> Reciprocating <input type="checkbox"/> Centrifugal <input type="checkbox"/> Other	
(Use a second sheet if needed)	
18. Elevation: Topography: <input type="checkbox"/> Hill <input type="checkbox"/> Slope <input checked="" type="checkbox"/> Upland <input type="checkbox"/> Valley	19. Remarks: 20. Water well contractor's certification: This well was drilled under my jurisdiction and this report is true to the best of my knowledge and belief. <u>KARST WATER WELL DRILL</u> Business name <u> </u> License No. <u> </u> Address <u>112 W. 140</u> <u>143A</u> Signed <u>[Signature]</u> Date <u>1/5/77</u> Authorized representative

T 14 R 18 S E 1/4 SE 1/4 NW 1/4

Forward the white, blue and pink copies to the Department of Health and Environment

Form WWC-5