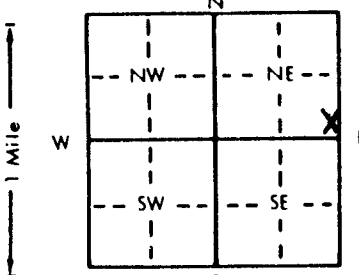


WELL: 1115	Fraction: SE 1/4 SE 1/4 NE 1/4	Section Number: 4	Township Number: T 14 S	Range Number: R 18 EW
------------	--------------------------------	-------------------	-------------------------	-----------------------

direction from nearest town or city street address of well if located within city?

703 Vine

2) WATER WELL OWNER: Duane M. Creamer
 RR#, St. Address, Box #: 703 Vine
 City, State, ZIP Code: Hays, KS 67601
 Board of Agriculture, Division of Water Resources
 Application Number:

3) LOCATE WELL'S LOCATION WITH AN "X" IN SECTION BOX:

 4) DEPTH OF COMPLETED WELL: 30.0 ft. ELEVATION:
 Depth(s) Groundwater Encountered 1. 20.0 ft. 2. ft. 3. ft.
 WELL'S STATIC WATER LEVEL 16.51 ft. below land surface measured on mo/day/yr 08-16-93
 Pump test data: Well water was ft. after hours pumping gpm
 Est. Yield gpm: Well water was ft. after hours pumping gpm
 Bore Hole Diameter in. to ft. and in. to ft.
 WELL WATER TO BE USED AS:
 1 Domestic 2 Irrigation 3 Feedlot 4 Industrial 5 Public water supply 6 Oil field water supply 7 Lawn and garden only 8 Air conditioning 9 Dewatering 10 Monitoring well 11 Injection well 12 Other (Specify below)
 Was a chemical/bacteriological sample submitted to Department? Yes No X; If yes, mo/day/yr sample was submitted Water Well Disinfected? Yes No X

5) TYPE OF BLANK CASING USED:
 1 Steel 2 PVC 3 RMP (SR) 4 ABS 5 Wrought iron 6 Asbestos-Cement 7 Fiberglass 8 Concrete tile 9 Other (specify below)
 CASING JOINTS: Glued Clamped Welded Threaded X
 Blank casing diameter 2 in. to 13 in. Dia ft. Dia ft. Dia in. to ft.
 Casing height above land surface 0 in., weight lbs./ft. Wall thickness or gauge No.
 TYPE OF SCREEN OR PERFORATION MATERIAL:
 1 Steel 2 Brass 3 Stainless steel 4 Galvanized steel 5 Fiberglass 6 Concrete tile 7 PVC 8 RMP (SR) 9 ABS 10 Asbestos-cement 11 Other (specify) 12 None used (open hole)
 SCREEN OR PERFORATION OPENINGS ARE:
 1 Continuous slot 2 Louvered shutter 3 Mill slot 4 Key punched 5 Gauzed wrapped 6 Wire wrapped 7 Torch cut 8 Saw cut 9 Drilled holes 10 Other (specify) 11 None (open hole)
 SCREEN-PERFORATED INTERVALS: From 28 ft. to 13.0 ft., From ft. to ft., From ft. to ft.
 GRAVEL PACK INTERVALS: From 30.0 ft. to 11.0 ft., From ft. to ft., From ft. to ft.

6) GROUT MATERIAL: 1 Neat cement 2 Cement grout 3 Bentonite 4 Other
 Grout Intervals: From 0 ft. to 10 ft., From 10 ft. to 11.0 ft., From ft. to ft.
 What is the nearest source of possible contamination:
 1 Septic tank 2 Sewer lines 3 Watertight sewer lines 4 Lateral lines 5 Cess pool 6 Seepage pit 7 Pit privy 8 Sewage lagoon 9 Feedyard 10 Livestock pens 11 Fuel storage 12 Fertilizer storage 13 Insecticide storage 14 Abandoned water well 15 Oil well/Gas well 16 Other (specify below)
 Direction from well? east How many feet? 10

FROM	TO	LITHOLOGIC LOG	FROM	TO	PLUGGING INTERVALS
0	3"	ASPHALT			
3"	9'	MED BRN CLY, MOD SLTY			Flush Cover
9	15	LT BRN, CLY, V SLTY, DAMP			ID # 00072395
15	20	LT GRV, CLY, V SLTY, MOIST			MW1
20	20.5	LT BRN SND, F TO V C, WITH F TO M GRVL, CLY MATRIX, SATUR.			
20.5	30	LT GRV, CLY, V SLTY, TR SND, SATUR.			

7) CONTRACTOR'S OR LANDOWNER'S CERTIFICATION: This water well was 1) constructed, (2) reconstructed, or (3) plugged under my jurisdiction and was completed on (mo/day/year) 08-09-93 and this record is true to the best of my knowledge and belief. Kansas Water Well Contractor's License No. 527 This Water Well Record was completed on (mo/day/yr) 08-17-93 under the business name of GeoCore Services, Inc. by (signature) Doug Ray