


1 LOCATION OF WATER WELL: County: Ellis Fraction SE 1/4 SE 1/4 NE 1/4 Section Number 4 Township Number T 14 S Range Number R 18 EW

Distance and direction from nearest town or city street address of well if located within city? 703 Vine

2 WATER WELL OWNER: Duane M. Creamer RR#, St. Address, Box #: 703 Vine City, State, ZIP Code: Hays, KS 67601 Board of Agriculture, Division of Water Resources Application Number:

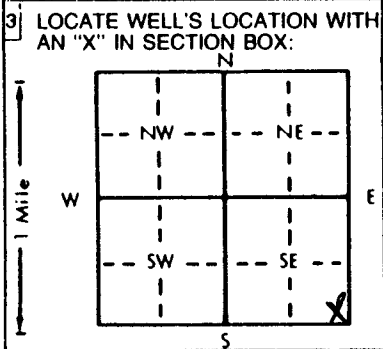

3 LOCATE WELL'S LOCATION WITH AN 'X' IN SECTION BOX: 4 DEPTH OF COMPLETED WELL: 28 ft. ELEVATION: 28 ft. Depth(s) Groundwater Encountered: 1.25 ft. 2. ft. 3. ft. WELL'S STATIC WATER LEVEL: 15.95 ft. below land surface measured on mo/day/yr 08-16-93

5 TYPE OF BLANK CASING USED: 1 Steel, 2 PVC, 3 RMP (SR), 4 ABS, 5 Wrought iron, 6 Asbestos-Cement, 7 Fiberglass, 8 Concrete tile, 9 Other (specify below), 10 Asbestos-cement, 11 Injection well, 12 Other (Specify below) CASING JOINTS: Glued, Clamped, Welded, Threaded. X

6 GROUT MATERIAL: 1 Neat cement, 2 Cement grout, 3 Bentonite, 4 Other Grout intervals: From 0 ft. to 9 ft., From 9 ft. to 11 ft., From ft. to ft. What is the nearest source of possible contamination: 1 Septic tank, 4 Lateral lines, 7 Pit privy, 10 Livestock pens, 14 Abandoned water well, 2 Sewer lines, 5 Cess pool, 8 Sewage lagoon, 12 Fertilizer storage, 15 Oil well/Gas well, 3 Watertight sewer lines, 6 Seepage pit, 9 Feedyard, 13 Insecticide storage, 16 Other (specify below)

Direction from well? southeast How many feet? 110

FROM	TO	LITHOLOGIC LOG	FROM	TO	PLUGGING INTERVALS
0	4"	ASPHALT			
4"	4'	DRK BRN CLY, SLTY, DAMP			
4	15	MOD BRN CLY, V SLTY TO SLTY, DAMP			Flush Cover ID # 00072364 MW10
15	28	CLY, LT TO MOD BRN, V SLTY, MOIST			

7 CONTRACTOR'S OR LANDOWNER'S CERTIFICATION: This water well was (1) constructed, (2) reconstructed, or (3) plugged under my jurisdiction and was completed on (mo/day/year) 08-11-93 and this record is true to the best of my knowledge and belief. Kansas Water Well Contractor's License No. 527 This Water Well Record was completed on (mo/day/yr) 08-17-93 under the business name of GeoCore Services, Inc. by (signature) Doug Ray