USE TYPEWRITER OR BALL POINT PEN-PRESS FIRMLY, PRINT CLEARLY.

WATER WELL RECORD
KSA 82a-1201-1215

Kansas Department of Health and Environment-Division of Environment
(Water well Contractors)
Topeka, Kansas 66620

1. Location of well:	County	Fraction	Section number	Township number	Range number
	Ellis	SW 1/4 NE 1/4 NE 1/4	10	T 14 S	R 18 E/W

2. Distance and direction from nearest town or city:
Street address of well location if in city: Hillside Dr. Hays, Ks.

3. Owner of well: Richard Plywell
R.R. or street: Hillside Dr.
City, state, zip code: Hays, Ks.

4. Locate with "X" in section below:

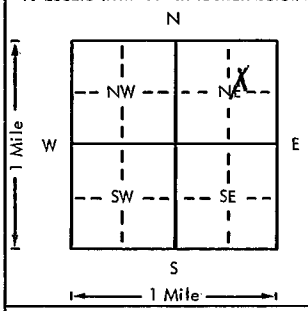

Sketch map:

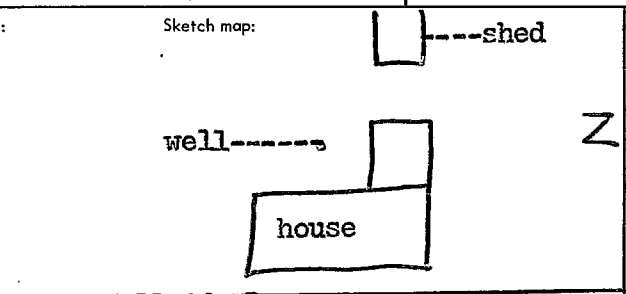

6. Bore hole dia. 9 in. Completion date 6-20-79
Well depth 80 ft.

7. __ Cable tool X Rotary __ Driven __ Dug
__ Hollow rod __ Jetted __ Bored __ Reverse rotary

8. Use: X Domestic __ Public supply __ Industry
__ Irrigation __ Air conditioning __ Stock
__ Lawn __ Oil field water __ Other

9. Casing: Material pvc
Threaded __ Welded X
RMP __ PVC X
Dia. 5 in. to 80 ft. depth
Dio. __ in. to __ ft. depth
Height: Above or below Surface 16 in.
Weight 200 lbs./ft.
Wall Thickness: inches or gage No. .26

5. Type and color of material	From	To
topsoil	0	4
clay	4	39
sand and clay	39	58
medium to coarse sand	58	76
blue shale	76	80
(Use a second sheet if needed)		

10. Screen: Manufacturer's name jet stream
Type pvc Dia. 5
Slot size .031 Length 10
Set between 70 ft. and 80 ft.
__ ft. and __ ft.
Gravel pack? xx Size range of material 1/4-1/2

11. Static water level: 50 ft. below land surface Date 6-20-79 mo./day/yr.

12. Pumping level below land surfaces:
50 ft. after 1 hrs. pumping 15 g.p.m.
__ ft. after __ hrs. pumping __ g.p.m.
Estimated maximum yield 15 g.p.m.

13. Water sample submitted: mo./day/yr.
__ Yes X No Date

14. Well head completion:
__ Pitless adapter 16 Inches above grade

15. Well grouted? X
With: X Neat cement __ Bentonite __ Concrete
Depth: From 1 ft. to 14 ft.

16. Nearest source of possible contamination:
ft. 100 Direction SW Type sewer
Well disinfected upon completion? X Yes __ No

17. Pump: X Not installed
Manufacturer's name
Model number HP Volts
Length of drop pipe ft. capacity g.p.m.
Type:
__ Submersible __ Turbine
__ Jet __ Reciprocating
__ Centrifugal __ Other

18. Elevation:
Topography:
__ Hill
X Slope
__ Upland
__ Valley

19. Remarks:

20. Water well contractor's certification:
This well was drilled under my jurisdiction and this report is true to the best of my knowledge and belief.
Karst Water Well 199
Business name License No.
Address E. Hiway 40 Hays, Ks.
Signed Mel Karst Date 6-20-79
Authorized representative

T 14 R 18 E/W Sec 10 1/4 SW 1/4 NE 1/4

Forward the white, blue and pink copies to the Department of Health and Environment

Form WWC-5

MI-1023