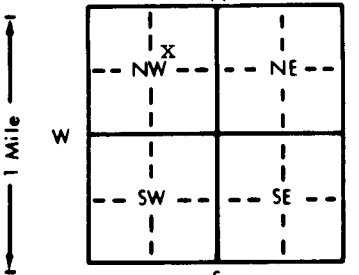


1 LOCATION OF WATER WELL:		Fraction	Section Number	Township Number	Range Number	
County: Ellis		SW 1/4 NE 1/4 NW 1/4	20	T 14 S	R 18 EW	
Distance and direction from nearest town or city street address of well if located within city? Approximately 2 3/4 miles south and 3/4 mile west of Hays	
2 WATER WELL OWNER: Hays, City of RR#, St. Address, Box #: P.O. Box 490 City, State, ZIP Code: Hays, KS 67601 Board of Agriculture, Division of Water Resources Application Number: 40,705	
3 LOCATE WELL'S LOCATION WITH AN "X" IN SECTION BOX:		4 DEPTH OF COMPLETED WELL: 476 ft. ELEVATION: unknown	
		Depth(s) Groundwater Encountered 1. ft. 2. ft. 3. ft. WELL'S STATIC WATER LEVEL: 195.5 ft. below land surface measured on mo/day/yr 7-1-92 Pump test data: Well water was not ch'd. ft. after hours pumping gpm Est. Yield unknown gpm: Well water was ft. after hours pumping gpm Bore Hole Diameter: 20 in. to 475 ft., and in. to ft. WELL WATER TO BE USED AS: 5 Public water supply 8 Air conditioning 11 Injection well 1 Domestic 3 Feedlot 6 Oil field water supply 9 Dewatering 12 Other (Specify below) 2 Irrigation 4 Industrial 7 Lawn and garden only 10 Monitoring well Was a chemical/bacteriological sample submitted to Department? Yes.....No.....X.....; If yes, mo/day/yr sample was submitted Water Well Disinfected? Yes X No	
5 TYPE OF BLANK CASING USED: 1 Steel 3 RMP (SR) 5 Wrought iron 8 Concrete tile CASING JOINTS: Glued Clamped 2 PVC 4 ABS 6 Asbestos-Cement 9 Other (specify below) Welded X 7 Fiberglass Threaded Blank casing diameter .8 5/8 in. to 345 ft., Dia .8 5/8 in. to 377 ft., Dia .8 5/8 in. to 395 in. to 8 5/8 in. to 455 ft. Casing height above land surface: 12 in., weight 33.04 lbs./ft. Wall thickness or gauge No. 375 TYPE OF SCREEN OR PERFORATION MATERIAL: 1 Steel 3 Stainless steel 5 Fiberglass 8 RMP (SR) 10 Asbestos-cement 11 Other (specify) 2 Brass 4 Galvanized steel 6 Concrete tile 9 ABS 12 None used (open hole) SCREEN OR PERFORATION OPENINGS ARE: 1 Continuous slot 3 Mill slot 5 Gauzed wrapped 8 Saw cut 11 None (open hole) 2 Louvered shutter 4 Key punched 6 Wire wrapped 9 Drilled holes 7 Torch cut 10 Other (specify) SCREEN-PERFORATED INTERVALS: From 345 ft. to 365 ft., From 395 ft. to 445 ft. From 377 ft. to 382 ft., From 455 ft. to 475 ft. GRAVEL PACK INTERVALS: From 295 ft. to 475 ft., From ft. to ft. SAND FILL: From 60 ft. to 222 ft., From ft. to ft.	
6 GROUT MATERIAL: 1 Neat cement 2 Cement grout 3 Bentonite 4 Other Bentonite Holeplug Grout Intervals: From ft. to ft., From 0 ft. to 60 ft., From 222 ft. to 295 ft. What is the nearest source of possible contamination: 1 Septic tank 4 Lateral lines 7 Pit privy 10 Livestock pens 14 Abandoned water well 2 Sewer lines 5 Cess pool 8 Sewage lagoon 11 Fuel storage 15 Oil well/Gas well 3 Watertight sewer lines 6 Seepage pit 9 Feedyard 12 Fertilizer storage 16 Other (specify below) 13 Insecticide storage Direction from well? southeast How many feet? 223	
<table border="1"><thead><tr><th>FROM</th><th>TO</th><th>LITHOLOGIC LOG</th><th>FROM</th><th>TO</th><th>PLUGGING INTERVALS</th></tr></thead><tbody><tr><td>0</td><td>4</td><td>Topsoil, clay</td><td>231</td><td>235</td><td>Clay, tan, shale, gray</td></tr><tr><td>4</td><td>55</td><td>Shale, weathered, gray</td><td>235</td><td>255</td><td>Shale, bentonite mixed</td></tr><tr><td>55</td><td>75</td><td>Shale, light gray, soft</td><td>255</td><td>265</td><td>Shale, hard, gray</td></tr><tr><td>75</td><td>95</td><td>Shale, gray, soft</td><td>265</td><td>290</td><td>Shale, gray, silty</td></tr><tr><td>95</td><td>115</td><td>Shale, some bentonite clay</td><td>290</td><td>315</td><td>Bentonite clay</td></tr><tr><td>115</td><td>135</td><td>Shale, silty, soft</td><td>315</td><td>325</td><td>Sandstone</td></tr><tr><td>135</td><td>175</td><td>Shale, gray, bentonite mixed</td><td>325</td><td>330</td><td>Sand, hard</td></tr><tr><td>175</td><td>195</td><td>Shale, bentonite mixed</td><td>330</td><td>335</td><td>Sand, fine, very fine, clean</td></tr><tr><td>195</td><td>200</td><td>Shale, light, dark gray</td><td>335</td><td>340</td><td>Clay, sand mixed</td></tr><tr><td>200</td><td>205</td><td>Shale, bentonite</td><td>340</td><td>345</td><td>Sand, fine, clean</td></tr><tr><td>205</td><td>208</td><td>Shale, clayey</td><td>345</td><td>355</td><td>Sand, clean, medium</td></tr><tr><td>208</td><td>209</td><td>Limestone, light gray</td><td>355</td><td>364</td><td>Sand, hard, cemented</td></tr><tr><td>209</td><td>215</td><td>Shale, gray</td><td>364</td><td>375</td><td>Sand, cemented, hard</td></tr><tr><td>215</td><td>230</td><td>Shale, gray to dark gray</td><td>375</td><td>383</td><td>Sandstone, clean</td></tr><tr><td>230</td><td>231</td><td>Limestone, hard</td><td></td><td></td><td>CONTINUED ON PAGE 2</td></tr>
7 CONTRACTOR'S OR LANDOWNER'S CERTIFICATION: This water well was (1) constructed, (2) reconstructed, or (3) plugged under my jurisdiction and was completed on (mo/day/year) 7-1-92 and this record is true to the best of my knowledge and belief. Kansas Water Well Contractor's License No. 185 This Water Well Record was completed on (mo/day/yr) 9-8-92 under the business name of Clarke Well & Equipment, Inc. by (signature) See page 2	

[illegible]