


1 LOCATION OF WATER WELL: County: Ellis Fraction NW 1/4 SW 1/4 NE 1/4 Section Number 25 Township Number T 14 S Range Number R 18 E/W

Distance and direction from nearest town or city street address of well if located within city? In Munya

2 WATER WELL OWNER: Eddie Tucker RR#, St. Address, Box #: Munya, KS City, State, ZIP Code: Board of Agriculture, Division of Water Resources Application Number:

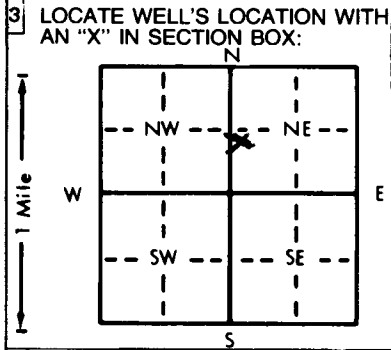

3 LOCATE WELL'S LOCATION WITH AN 'X' IN SECTION BOX: 4 DEPTH OF COMPLETED WELL: 36 ft. ELEVATION: Depth(s) Groundwater Encountered 1. 23 ft. 2. 3. ft. 3. ft. WELL'S STATIC WATER LEVEL 77.8 ft. below land surface measured on mo/day/yr 10/6/84 Pump test data: Well water was ft. after hours pumping gpm Est. Yield 259 gpm: Well water was ft. after hours pumping gpm Bore Hole Diameter 10 1/4 in. to 36 ft. ft., and in. to ft. WELL WATER TO BE USED AS: 5 Public water supply 8 Air conditioning 11 Injection well 1 Domestic 3 Feedlot 6 Oil field water supply 9 Dewatering 12 Other (Specify below) 2 Irrigation 4 Industrial 10 Observation well Lawn and garden only Was a chemical/bacteriological sample submitted to Department? Yes No X; If yes, mo/day/yr sample was submitted Water Well Disinfected? Yes No X

5 TYPE OF BLANK CASING USED: 1 Steel 2 PVC 3 RMP (SR) 4 ABS 5 Wrought iron 6 Asbestos-Cement 7 Fiberglass 8 Concrete tile 9 Other (specify below) CASING JOINTS: Glued X Clamped Welded Threaded Blank casing diameter 5.56 in. to 16 ft., Dia in. to ft., Dia in. to ft. Casing height above land surface 20 inches in., weight lbs./ft. Wall thickness or gauge No. SDR 26 TYPE OF SCREEN OR PERFORATION MATERIAL: 1 Steel 2 Brass 3 Stainless steel 4 Galvanized steel 5 Fiberglass 6 Concrete tile 7 PVC 8 RMP (SR) 9 ABS 10 Asbestos-cement 11 Other (specify) 12 None used (open hole) SCREEN OR PERFORATION OPENINGS ARE: 1 Continuous slot 2 Louvered shutter 3 Mill slot 4 Key punched 5 Gauzed wrapped 6 Wire wrapped 7 Torch cut 8 Saw cut 9 Drilled holes 10 Other (specify) 11 None (open hole) SCREEN-PERFORATED INTERVALS: From 36 ft. to 16 ft. From ft. to ft. From ft. to ft. GRAVEL PACK INTERVALS: From 36 ft. to 10 ft. From ft. to ft. From ft. to ft.

6 GROUT MATERIAL: 1 Neat cement 2 Cement grout 3 Bentonite 4 Other Grout intervals: From 10 ft. to 0 ft. From ft. to ft. From ft. to ft. What is the nearest source of possible contamination: 1 Septic tank 2 Sewer lines 3 Watertight sewer lines 4 Lateral lines 5 Cess pool 6 Seepage pit 7 Pit privy 8 Sewage lagoon 9 Feedyard 10 Livestock pens 11 Fuel storage 12 Fertilizer storage 13 Insecticide storage 14 Abandoned water well 15 Oil well/Gas well 16 Other (specify below) Direction from well? South How many feet? 50 ft

FROM	TO	LITHOLOGIC LOG	FROM	TO	LITHOLOGIC LOG
0	4	01 top soil			
4	12	04 clay yellow w fine sand mixed			
12	32	05 fine to medium sand			
32	36	19 shale			

7 CONTRACTOR'S OR LANDOWNER'S CERTIFICATION: This water well was (1) constructed (2) reconstructed, or (3) plugged under my jurisdiction and was completed on (mo/day/year) 10/6/84 and this record is true to the best of my knowledge and belief. Kansas Water Well Contractor's License No. 455 This Water Well Record was completed on (mo/day/yr) 10/16/84 under the business name of Kraus Pump & Supply by (signature) James Tucker INSTRUCTIONS: Use typewriter or ball point pen, PLEASE PRESS FIRMLY and PRINT clearly. Please fill in blanks, underline or circle the correct answers. Send top three copies to Kansas Department of Health and Environment, Division of Environment, Environmental Geology Section, Topeka, KS 66620. Send one to WATER WELL OWNER and retain one for your records.