


1 LOCATION OF WATER WELL: Fraction NE 1/4 SE 1/4 SW 1/4 Section Number 3 Township Number T 14 S Range Number R 18 E/W  
 County: Ellis Distance and direction from nearest town or city street address of well if located within city?

1015 Military Road Hays, Kansas

2 WATER WELL OWNER: Champion Chemicals, Inc. Board of Agriculture, Division of Water Resources  
 RR#, St. Address, Box # : 1015 Military Road Application Number:  
 City, State, ZIP Code : Hays, Kansas 67601

3 LOCATE WELL'S LOCATION WITH AN "X" IN SECTION BOX:

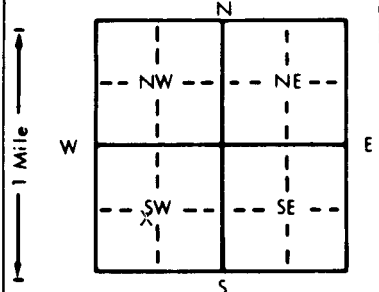

4 DEPTH OF COMPLETED WELL: 45 ft. ELEVATION: Upland  
 Depth(s) Groundwater Encountered 1. 32 ft. 2. ft. 3. ft.  
 WELL'S STATIC WATER LEVEL 18 ft. below land surface measured on mo/day/yr 8/15/97  
 Pump test data: Well water was 18 ft. after 1 hours pumping 20 gpm  
 Est. Yield 20 gpm: Well water was ft. after hours pumping gpm  
 Bore Hole Diameter 10 in. to 45 ft., and in. to ft.  
 WELL WATER TO BE USED AS: 10 5 Public water supply 8 Air conditioning 11 Injection well  
 1 Domestic 3 Feedlot 6 Oil field water supply 9 Dewatering 12 Other (Specify below)  
 2 Irrigation 4 Industrial 7 Lawn and garden only 10 Monitoring well  
 Was a chemical/bacteriological sample submitted to Department? Yes No X; If yes, mo/day/yr sample was submitted  
 Water Well Disinfected? Yes X No

5 TYPE OF BLANK CASING USED: 2 5 Wrought iron 8 Concrete tile CASING JOINTS: Glued Clamped  
 1 Steel 3 RMP (SR) 6 Asbestos-Cement 9 Other (specify below) Welded  
 2 PVC 4 ABS 7 Fiberglass Threaded Screwed

Blank casing diameter 5 in. to 25 ft., Dia. in. to ft., Dia. in. to ft.  
 Casing height above land surface 24 in., weight 2.29 lbs./ft. Wall thickness or gauge No. 26

TYPE OF SCREEN OR PERFORATION MATERIAL: 7 7 PVC 10 Asbestos-cement  
 1 Steel 3 Stainless steel 5 Fiberglass 8 RMP (SR) 11 Other (specify)  
 2 Brass 4 Galvanized steel 6 Concrete tile 9 ABS 12 None used (open hole)

SCREEN OR PERFORATION OPENINGS ARE: 8 5 Gauzed wrapped 8 Saw cut 11 None (open hole)  
 1 Continuous slot 3 Mill slot 6 Wire wrapped 9 Drilled holes  
 2 Louvered shutter 4 Key punched 7 Torch cut 10 Other (specify)

SCREEN-PERFORATED INTERVALS: From 45 ft. to 25 ft., From ft. to ft.  
 From ft. to ft., From ft. to ft.  
 GRAVEL PACK INTERVALS: From 20 ft. to 45 ft., From ft. to ft.  
 From ft. to ft., From ft. to ft.

6 GROUT MATERIAL: 3 1 Neat cement 2 Cement grout 3 Bentonite 4 Other  
 Grout Intervals: From 0 ft. to 20 ft., From ft. to ft., From ft. to ft.

What is the nearest source of possible contamination: None 10 Livestock pens 14 Abandoned water well  
 1 Septic tank 4 Lateral lines 7 Pit privy 11 Fuel storage 15 Oil well/Gas well  
 2 Sewer lines 5 Cess pool 8 Sewage lagoon 12 Fertilizer storage 16 Other (specify below)  
 3 Watertight sewer lines 6 Seepage pit 9 Feedyard 13 Insecticide storage

Direction from well? How many feet?

FROM	TO	LITHOLOGIC LOG	FROM	TO	PLUGGING INTERVALS
0	4	Topsoil			
4	18	Gumbo			
18	28	River mud			
28	32	Gray clay			
32	36	Sand			
36	45	Shale			

7 CONTRACTOR'S OR LANDOWNER'S CERTIFICATION: This water well was (1) constructed, (2) reconstructed, or (3) plugged under my jurisdiction and was completed on (mo/day/year) 8/15/97 and this record is true to the best of my knowledge and belief. Kansas Water Well Contractor's License No. 199 This Water Well Record was completed on (mo/day/yr) 8/27/97 under the business name of Karst Water Well Drilling & Service, Inc. by (signature)

OFFICE USE ONLY  
T  
R  
EW  
SEC  
1/4  
1/4  
1/4