


1 LOCATION OF WATER WELL: Fraction NE 1/4 NE 1/4 NW 1/4 Section Number 4 Township Number T 14 S Range Number R 18 E/W

Distance and direction from nearest town or city street address of well if located within city? 201 E. 7th, Hays, Kansas

2 WATER WELL OWNER: Hays Medical Center RR#, St. Address, Box # : 201 E. 7th Board of Agriculture, Division of Water Resources City, State, ZIP Code : Hays, Kansas 67601 Application Number:

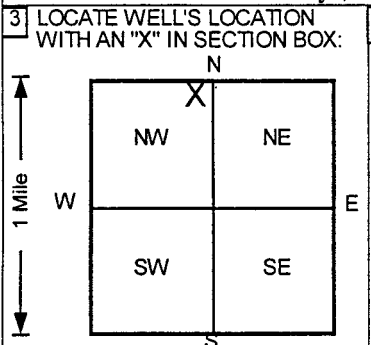

3 LOCATE WELL'S LOCATION WITH AN "X" IN SECTION BOX: 4 DEPTH OF COMPLETED WELL 22 ft ELEVATION: 1991.3. WELL'S STATIC WATER LEVEL... Pump test data: Well water was NA ft after... hours pumping... gpm. Est. Yield NA gpm: Well water was... ft after... hours pumping... gpm. Bore Hole Diameter 8 in. to 22 ft, and... in. to... ft. WELL WATER TO BE USED AS: 5 Public water supply 8 Air conditioning 11 Injection well 1 Domestic 3 Feedlot 6 Oil field water supply 9 Dewatering 12 Other (Specify below) 2 Irrigation 4 Industrial 7 Lawn and garden only 10 Monitoring well. Was a chemical/bacteriological sample submitted to Department? Yes.....No.....; If yes, mo/day/yr sample was submitted. Water Well Disinfected? Yes No

5 TYPE OF BLANK CASING USED: 1 Steel 3 RMP (SR) 5 Wrought iron 8 Concrete tile CASING JOINTS: Glued... Clamped... 2 PVC 4 ABS 7 Fiberglass Threaded. 10 Asbestos-cement 11 Other (specify)... 12 None used (open hole). Blank casing diameter 2 in. to 12 ft, Dia... in. to... ft, Dia... in. to... ft. Casing height above land surface -4.68 in., weight Sch 40 lbs./ft. Wall thickness or gauge No. TYPE OF SCREEN OR PERFORATION MATERIAL: 1 Steel 3 Stainless steel 5 Fiberglass 8 RMP (SR) 11 Other (specify)... 12 None used (open hole). 2 Brass 4 Galvanized steel 6 Concrete tile 9 ABS. SCREEN OR PERFORATION OPENINGS ARE: 1 Continuous slot 3 Mill slot 5 Gauzed wrapped 8 Saw cut 11 None (open hole) 2 Louvered shutter 4 Key punched 6 Wire wrapped 9 Drilled holes 10 Other (specify)... SCREEN-PERFORATED INTERVALS: From 12 ft to 22 ft, From... ft to... ft, From... ft to... ft. GRAVEL PACK INTERVALS: From 10 ft to 22 ft, From... ft to... ft, From... ft to... ft.

6 GROUT MATERIAL: 1 Neat cement 2 Cement grout 3 Bentonite 4 Other. Grout Intervals: From 0 ft to 8 ft, From 8 ft to 10 ft, From... ft to... ft. What is the nearest source of possible contamination: 1 Septic tank 4 Lateral lines 7 Pit privy 10 Livestock pens 14 Abandoned water well 2 Sewer lines 5 Cess pool 8 Sewage lagoon 11 Fuel storage 15 Oil well/Gas well 3 Watertight sewer lines 6 Seepage pit 9 Feedyard 12 Fertilizer storage 16 Other (specify below) Former Tank Basin. Direction from well? How many feet?

Table with columns: FROM, TO, LITHOLOGIC LOG, FROM, TO, PLUGGING INTERVALS. Rows: 0-2 Clay, Dark Brown; 2-10 Clay, Red brown; 10-15 Sand, Light Brown; 15-22 Sand, Brown; MW4, Tag # 00274856, Flushmount; Project Name: Hays Medical Center-St. Hadley Campus; GeoCore # 688, KDHE # U6 026 11577.

7 CONTRACTOR'S OR LANDOWNER'S CERTIFICATION: This water well was 1 constructed, 2 reconstructed, or 3 plugged under my jurisdiction and was completed on (mo/day/year) 11/17/98 and this record is true to the best of my knowledge and belief. Kansas Water Well Contractor's License No. 527 This Water Well Record was completed on (mo/day/yr) 12/10/98 under the business name of GeoCore Services, Inc. by (signature) Dale Holt