


1 LOCATION OF WATER WELL: County: Ellis Fraction: SE 1/4 NE 1/4 NW 1/4 Section Number: 4 Township Number: T 14 S Range Number: R 18

Distance and direction from nearest town or city street address of well if located within city? 201 E. 7th, Hays, Kansas

2 WATER WELL OWNER: Hays Medical Center RR#, St. Address, Box #: 201 E. 7th City, State, ZIP Code: Hays, Kansas 67601 Board of Agriculture, Division of Water Resources Application Number:

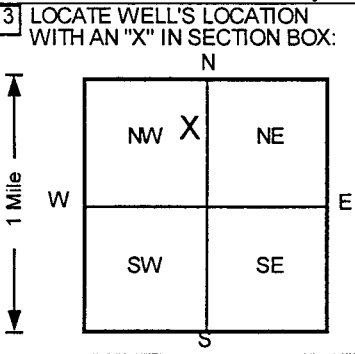

3 LOCATE WELL'S LOCATION WITH AN 'X' IN SECTION BOX: 4 DEPTH OF COMPLETED WELL: 20 ft. ELEVATION: 1989.44. WELL'S STATIC WATER LEVEL: 14.87 ft. below land surface measured on mo/day/yr: 11/18/98. Pump test data: Well water was NA ft. after ... hours pumping ... gpm. Est. Yield: NA gpm. Well water was ... ft. after ... hours pumping ... gpm. Bore Hole Diameter: 8 in. to 20 ft. and ... in. to ... ft. WELL WATER TO BE USED AS: 10 Monitoring well. Was a chemical/bacteriological sample submitted to Department? Yes.....No.....; If yes, mo/day/yr sample was submitted. Water Well Disinfected? Yes No

5 TYPE OF BLANK CASING USED: 2 PVC, 7 Fiberglass, 10 Asbestos-cement. CASING JOINTS: Threaded. Blank casing diameter: 2 in. to 10 ft. Dia. ... in. to ... ft. Dia. ... in. to ... ft. Dia. ... in. to ... ft. Casing height above land surface: -5.04 in., weight: Sch 40 lbs./ft. Wall thickness or gauge No. TYPE OF SCREEN OR PERFORATION MATERIAL: 7 PVC, 10 Asbestos-cement, 11 Other (specify). SCREEN OR PERFORATION OPENINGS ARE: 3 Mill slot, 11 None (open hole). SCREEN-PERFORATED INTERVALS: From 10 ft to 20 ft. GRAVEL PACK INTERVALS: From 8 ft to 20 ft.

6 GROUT MATERIAL: 2 Cement grout, 3 Bentonite, 4 Other. Grout Intervals: From 0 ft to 6 ft, From 6 ft to 8 ft, From ... ft to ... ft. What is the nearest source of possible contamination: 16 Other (specify below) Former Tank Basin. Direction from well?

LITHOLOGIC LOG and PLUGGING INTERVALS table with columns for FROM, TO, and descriptions of layers like Concrete, Clay, Sand, etc.

7 CONTRACTOR'S OR LANDOWNER'S CERTIFICATION: This water well was (1) constructed, (2) reconstructed, or (3) plugged under my jurisdiction and was completed on (mo/day/year) 11/16/98 and this record is true to the best of my knowledge and belief. Kansas Water Well Contractor's License No. 527. This Water Well Record was completed on (mo/day/yr) 12/10/98 under the business name of GeoCore Services, Inc. by (signature) Dale Hill