


1 LOCATION OF WATER WELL: Fraction NW 1/4 SW 1/4 SW 1/4 Section Number 3 Township Number T 14 S Range Number R 18 EW  
 County: Ellis

Distance and direction from nearest town or city street address of well if located within city?  
 S Hwy 183 -- Hays KS

2 WATER WELL OWNER: Countryside of Hays  
 RR#, St. Address, Box #: P.O. Box 98 Board of Agriculture, Division of Water Resources  
 City, State, ZIP Code: Hays KS 67601 Application Number:

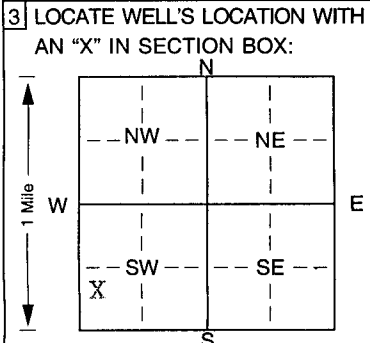

4 DEPTH OF COMPLETED WELL: 50 ft. ELEVATION: valley  
 Depth(s) Groundwater Encountered 1. 42 ft. 2. ft. 3. ft.  
 WELL'S STATIC WATER LEVEL: 30 ft. below land surface measured on mo/day/yr 5/7/01  
 Pump test data: Well water was 30 ft. after 2 hours pumping 20 gpm  
 Est. Yield 20 gpm: Well water was ft. after hours pumping gpm  
 Bore Hole Diameter: 10 in. to 50 ft., and in. to ft.  
 WELL WATER TO BE USED AS: 7 5 Public water supply 8 Air conditioning 11 Injection well  
 1 Domestic 3 Feedlot 6 Oil field water supply 9 Dewatering 12 Other (Specify below)  
 2 Irrigation 4 Industrial 7 Domestic (lawn & garden) 10 Monitoring well  
 Was a chemical/bacteriological sample submitted to Department? Yes. No. X; If yes, mo/day/yr sample was submitted Water Well Disinfected? Yes X No

5 TYPE OF BLANK CASING USED: 2 5 Wrought iron 8 Concrete tile CASING JOINTS: Glued. X Clamped.  
 1 Steel 3 RMP (SR) 6 Asbestos-Cement 9 Other (specify below) Welded  
 2 PVC 4 ABS 7 Fiberglass Threaded.  
 Blank casing diameter 5 in. to 30 ft., Dia in. to ft., Dia in. to ft.  
 Casing height above land surface 24 in., weight 2.29 lbs./ft. Wall thickness or gauge No. 26  
 TYPE OF SCREEN OR PERFORATION MATERIAL: 7 7 PVC 10 Asbestos-cement  
 1 Steel 3 Stainless steel 5 Fiberglass 8 RMP (SR) 11 Other (specify)  
 2 Brass 4 Galvanized steel 6 Concrete tile 9 ABS 12 None used (open hole)  
 SCREEN OR PERFORATION OPENINGS ARE: 8 5 Gauzed wrapped 8 Saw cut 11 None (open hole)  
 1 Continuous slot 3 Mill slot 6 Wire wrapped 9 Drilled holes  
 2 Louvered shutter 4 Key punched 7 Torch cut 10 Other (specify) ft.  
 SCREEN-PERFORATED INTERVALS: From 50 ft. to 30 ft., From ft. to ft.  
 From ft. to ft., From ft. to ft.  
 GRAVEL PACK INTERVALS: From 20 ft. to 50 ft., From ft. to ft.  
 From ft. to ft., From ft. to ft.

6 GROUT MATERIAL: 3 1 Neat cement 2 Cement grout 3 Bentonite 4 Other  
 Grout Intervals: From 0 ft. to 20 ft., From ft. to ft., From ft. to ft.  
 What is the nearest source of possible contamination:  
 1 Septic tank 4 Lateral lines 7 Pit privy 10 Livestock pens 14 Abandoned water well  
 2 Sewer lines 5 Cess pool 8 Sewage lagoon 11 Fuel storage 15 Oil well/Gas well  
 3 Watertight sewer lines 6 Seepage pit 9 Feedyard 12 Fertilizer storage 16 Other (specify below)  
 13 Insecticide storage  
 Direction from well? How many feet?

FROM	TO	LITHOLOGIC LOG	FROM	TO	PLUGGING INTERVALS
0	3	Topsoil			
3	20	Gumbo			
20	30	River Mud			
30	42	Course Sand			
42	50	Shale			

7 CONTRACTOR'S OR LANDOWNER'S CERTIFICATION: This water well was (1) constructed, (2) reconstructed, or (3) plugged under my jurisdiction and was completed on (mo/day/year) 5/7/01 and this record is true to the best of my knowledge and belief. Kansas Water Well Contractor's Licence No. 199 This Water Well Record was completed on (mo/day/yr) 5/17/01 under the business name of Karst Water Well Drilling & Service, Inc. by (signature) Mel Karst