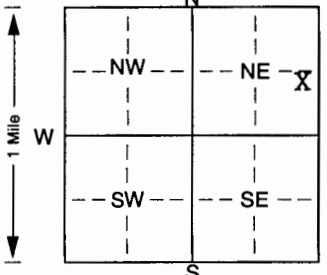


1 LOCATION OF WATER WELL: Fraction NE 1/4 SE 1/4 NE 1/4 Section Number 25 Township Number T 14 S Range Number R 18 EW
 County: Ellis

Distance and direction from nearest town or city street address of well if located within city?
1899 Kazan, Munjor KS

2 WATER WELL OWNER: Shayne Wilson
 RR#, St. Address, Box #: 1899 Kazan Board of Agriculture, Division of Water Resources
 City, State, ZIP Code: Munjor KS 67601 Application Number:

3 LOCATE WELL'S LOCATION WITH AN "X" IN SECTION BOX:  4 DEPTH OF COMPLETED WELL: 40 ft. ELEVATION: upland
 Depth(s) Groundwater Encountered 1. 14 ft. 2. 22 ft. 3. 22 ft.
 WELL'S STATIC WATER LEVEL: 22 ft. below land surface measured on mo/day/yr 8/2/01
 Pump test data: Well water was 22 ft. after 2 hours pumping 20 gpm
 Est. Yield 20 gpm: Well water was 22 ft. after 2 hours pumping 20 gpm
 Bore Hole Diameter: 10 in. to 40 ft., and 40 in. to 40 ft.
 WELL WATER TO BE USED AS: 7 5 Public water supply 8 Air conditioning 11 Injection well
 1 Domestic 3 Feedlot 6 Oil field water supply 9 Dewatering 12 Other (Specify below)
 2 Irrigation 4 Industrial 7 Domestic (lawn & garden) 10 Monitoring well
 Was a chemical/bacteriological sample submitted to Department? Yes. No X. . . . ; If yes, mo/day/yrs sample was submitted Water Well Disinfected? Yes X No

5 TYPE OF BLANK CASING USED: 2 5 Wrought iron 8 Concrete tile CASING JOINTS: Glued. X Clamped.
 1 Steel 3 RMP (SR) 6 Asbestos-Cement 9 Other (specify below) Welded
2 PVC 4 ABS 7 Fiberglass Threaded
 Blank casing diameter 5 in. to 20 ft., Dia 20 in. to 20 ft., Dia 20 in. to 20 ft.
 Casing height above land surface: 24 in., weight 2.29 lbs./ft. Wall thickness or gauge No. .26
 TYPE OF SCREEN OR PERFORATION MATERIAL: 7 7 PVC 10 Asbestos-cement
 1 Steel 3 Stainless steel 5 Fiberglass 8 RMP (SR) 11 Other (specify)
 2 Brass 4 Galvanized steel 6 Concrete tile 9 ABS 12 None used (open hole)
 SCREEN OR PERFORATION OPENINGS ARE: 8 5 Gauzed wrapped 8 Saw cut 11 None (open hole)
 1 Continuous slot 3 Mill slot 6 Wire wrapped 9 Drilled holes
 2 Louvered shutter 4 Key punched 7 Torch cut 10 Other (specify) ft.
 SCREEN-PERFORATED INTERVALS: From 40 ft. to 20 ft., From ft. to ft.
 From ft. to ft., From ft. to ft.
 GRAVEL PACK INTERVALS: From 20 ft. to 40 ft., From ft. to ft.
 From ft. to ft., From ft. to ft.

6 GROUT MATERIAL: 3 1 Neat cement 2 Cement grout 3 Bentonite 4 Other
 Grout Intervals: From 0 ft. to 20 ft., From ft. to ft., From ft. to ft.
 What is the nearest source of possible contamination:
 1 Septic tank 4 Lateral lines 7 Pit privy 10 Livestock pens 14 Abandoned water well
 2 Sewer lines 5 Cess pool 8 Sewage lagoon 11 Fuel storage 15 Oil well/Gas well
 3 Watertight sewer lines 6 Seepage pit 9 Feedyard 12 Fertilizer storage 16 Other (specify below)
 13 Insecticide storage
 Direction from well? How many feet?

FROM	TO	LITHOLOGIC LOG	FROM	TO	PLUGGING INTERVALS
0	4	Topsoil			
4	8	Gumbo			
8	14	Brown clay			
14	28	Sand			
28	40	Shale			

7 CONTRACTOR'S OR LANDOWNER'S CERTIFICATION: This water well was (1) constructed, (2) reconstructed, or (3) plugged under my jurisdiction and was completed on (mo/day/year) 8/2/01 and this record is true to the best of my knowledge and belief. Kansas Water Well Contractor's Licence No. 199 This Water Well Record was completed on (mo/day/yr) 8/21/01 under the business name of Karst Water Well Drilling & Service, Inc. by (signature) Mel Kuss