


1 LOCATION OF WATER WELL: County: <b>Ellis</b>	Fraction <b>NW ¼ SE ¼ SE ¼</b>	Section Number <b>3</b>	Township Number <b>T 14 S</b>	Range Number <b>R 18 EW</b>
---------------------------------------------------	-----------------------------------	----------------------------	----------------------------------	--------------------------------

Distance and direction from nearest town or city street address of well if located within city?  
**2000 Front Street, Hays, Kansas**

2 WATER WELL OWNER: **Pepsi Cola Bottling**  
 RR#, St. Address, Box # : **PO Box 460** Board of Agriculture, Division of Water Resources  
 City, State, ZIP Code : **Hays, Kansas 67601** Application Number:

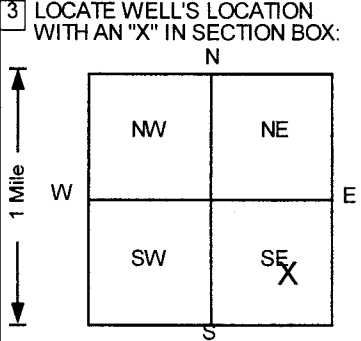

4 DEPTH OF COMPLETED WELL ..... **38** ..... ft ELEVATION: ..... **0** .....  
 Depth(s) Groundwater Encountered 1. .... ft 2. .... ft 3. .... ft  
 WELL'S STATIC WATER LEVEL ..... ft below land surface measured on mo/day/yr  
 Pump test data: Well water was **NA** ft after ..... hours pumping ..... gpm  
 Est. Yield **NA** gpm: Well water was ..... ft after ..... hours pumping ..... gpm  
 Bore Hole Diameter ..... **8** ..... in. to ..... **42** ..... ft, and ..... in. to ..... ft  
 WELL WATER TO BE USED AS: 5 Public water supply 8 Air conditioning 11 Injection well  
 1 Domestic 3 Feedlot 6 Oil field water supply 9 Dewatering **12 Other (Specify below)**  
 2 Irrigation 4 Industrial 7 Lawn and garden only 10 Monitoring well **Vapor Observation**  
 Was a chemical/bacteriological sample submitted to Department? Yes.....No ; If yes, mo/day/yr sample was submitted  
 Water Well Disinfected? Yes No

5 TYPE OF BLANK CASING USED:  
 1 Steel 3 RMP (SR) 5 Wrought iron 8 Concrete tile CASING JOINTS: Glued ..... Clamped .....  
**2 PVC** 4 ABS 6 Asbestos-Cement 9 Other (specify below) Welded .....  
 7 Fiberglass Threaded   
 Blank casing diameter ..... **2** ..... in. to ..... **33** ..... ft, Dia ..... in. to ..... ft, Dia ..... in. to ..... ft  
 Casing height above land surface ..... in., weight ..... lbs./ft. Wall thickness or gauge No. .... **Sch. 40** .....  
 TYPE OF SCREEN OR PERFORATION MATERIAL **7 PVC** 10 Asbestos-cement  
 1 Steel 3 Stainless steel 5 Fiberglass **8 RMP (SR)** 11 Other (specify) .....  
 2 Brass 4 Galvanized steel 6 Concrete tile 9 ABS 12 None used (open hole)  
 SCREEN OR PERFORATION OPENINGS ARE:  
 1 Continuous slot **3 Mill slot** 5 Gauzed wrapped 8 Saw cut 11 None (open hole)  
 2 Louvered shutter 4 Key punched 6 Wire wrapped 9 Drilled holes  
 7 Torch cut 10 Other (specify) .....  
 SCREEN-PERFORATED INTERVALS: From ..... **33** ..... ft to ..... **38** ..... ft, From ..... ft to ..... ft  
 GRAVEL PACK INTERVALS: From ..... **32** ..... ft to ..... **38** ..... ft, From ..... ft to ..... ft

6 GROUT MATERIAL: 1 Neat cement **2 Cement grout** **3 Bentonite** 4 Other .....  
 Grout Intervals: From ..... **0** ..... ft to ..... **31** ..... ft, From ..... **31** ..... ft to ..... **32** ..... ft, From ..... **38** ..... ft to ..... **42** ..... ft  
 What is the nearest source of possible contamination:  
 1 Septic tank 4 Lateral lines 7 Pit privy 10 Livestock pens 14 Abandoned water well  
 2 Sewer lines 5 Cess pool 8 Sewage lagoon 11 Fuel storage 15 Oil well/Gas well  
 3 Watertight sewer lines 6 Seepage pit 9 Feedyard 12 Fertilizer storage **16 Other (specify below)**  
 Direction from well? **W** **Former Tank Basin**  
 How many feet? **70**

FROM	TO	LITHOLOGIC LOG	FROM	TO	PLUGGING INTERVALS
0	5.5	Clay, Brown, silty, moist, soft	30	34.5	Clay, Gray, firm, very plastic
5.5	6	Clay, Light Brown, silty, stiff	34.5	36	Sand, Grayish Brown, very, very clayey
6	8	Clay, Light Brown, silty, very moist to wet	36	39.8	Clay, Tan, very silty, sandy
8	10	Clay, Light Brown, silty	39.8	40	Sand, Tan to Brown, fine to coarse grained
10	10.1	Limestone Gravel, wet			
10.1	10.5	Clay, Light Brown, silty, sandy			
10.5	15	Clay, Light Brown, silty			
15	15.1	Limestone, 1" in diameter in spoon			
15.1	20	Clay, Light Brown, silty, moist, soft			
20	20.1	Limestone Rock, 1" diameter in spoon			
20.1	25	Silt and Clay, Light Brown, sandy			
25	27	Silt, Brown, clayey, sandy			
27	28	Clay, Brown, silty, stiff			SVOB-4, Tag # 00306753, Flushmount
28	28.5	Silt, Brown, clayey, wet			Project Name: Pepsi-Cola Bottling Company - Remedial
28.5	30	Clay, Brown to Dark Brown			GeoCore # 708, KDHE # U6 026 00066B

7 CONTRACTOR'S OR LANDOWNER'S CERTIFICATION: This water well was **1** constructed, (2) reconstructed, or (3) plugged under my jurisdiction and was completed on (mo/day/year) ..... **6/6/03** ..... and this record is true to the best of my knowledge and belief.  
 Kansas Water Well Contractor's License No. .... **527** ..... This Water Well Record was completed on (mo/day/yr) ..... **6/26/03** .....  
 under the business name of **GeoCore Inc.** by (signature) *Dale P. Bell*