

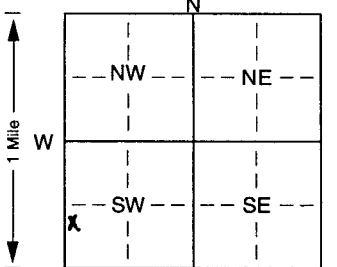
MW36D

00317203

1 LOCATION OF WATER WELL: Fraction NW SW 1/4 SW 1/4 NW 1/4 Section Number 3 Township Number T 14 S Range Number R 18 EW

Distance and direction from nearest town or city street address of well if located within city?
 703 Vine St. Hays, KS

2 WATER WELL OWNER: Mr Quick Mini-mart
 RR#, St. Address, Box #: 703 Vine St.
 City, State, ZIP Code: Hays, KS 67601
 Board of Agriculture, Division of Water Resources
 Application Number:

3 LOCATE WELL'S LOCATION WITH AN "X" IN SECTION BOX:

 4 DEPTH OF COMPLETED WELL: 46 ft. ELEVATION: 1982.29 grand elev.
 Depth(s) Groundwater Encountered: 1 21.44 ft. 2. 3. ft.
 WELL'S STATIC WATER LEVEL: 21.44 ft. below land surface measured on mo/day/yr 6-16-03
 Pump test data: Well water was ... ft. after ... hours pumping ... gpm
 Est. Yield ... gpm: Well water was ... ft. after ... hours pumping ... gpm
 Bore Hole Diameter: 8 in. to 46 in. and ... in. to ... ft.
 WELL WATER TO BE USED AS: 5 Public water supply 8 Air conditioning 11 Injection well
 1 Domestic 3 Feedlot 6 Oil field water supply 9 Dewatering 12 Other (Specify below)
 2 Irrigation 4 Industrial 7 Domestic (lawn & garden) 10 Monitoring well
 Was a chemical/bacteriological sample submitted to Department? Yes. No; If yes, mo/day/yr sample was submitted
 Water Well Disinfected? Yes No

5 TYPE OF BLANK CASING USED:
 1 Steel 3 RMP (SR) 5 Wrought iron 8 Concrete tile CASING JOINTS: Glued. Clamped.
 2 PVC 4 ABS 6 Asbestos-Cement 9 Other (specify below) Welded.
 7 Fiberglass Threaded. X
 Blank casing diameter: 2 in. to 31 ft., Dia. in. to ... ft., Dia. in. to ... ft.
 Casing height above land surface: 0.10 in., weight ... lbs./ft. Wall thickness or gauge No. sch. 40
 TYPE OF SCREEN OR PERFORATION MATERIAL:
 1 Steel 3 Stainless steel 5 Fiberglass 7 PVC 10 Asbestos-cement
 2 Brass 4 Galvanized steel 6 Concrete tile 8 RMP (SR) 11 Other (specify)
 9 ABS 12 None used (open hole)
 SCREEN OR PERFORATION OPENINGS ARE:
 1 Continuous slot 3 Mill slot 5 Gauzed wrapped 8 Saw cut 11 None (open hole)
 2 Louvered shutter 4 Key punched 7 Torch cut 9 Drilled holes
 10 Other (specify) ... ft.
 SCREEN-PERFORATED INTERVALS: From 31 ft. to 46 ft. From ... ft. to ... ft.
 GRAVEL PACK INTERVALS: From 29 ft. to 46 ft. From ... ft. to ... ft.

6 GROUT MATERIAL: 1 Neat cement 2 Cement grout 3 Bentonite 4 Other
 Grout Intervals: From 3 ft. to 27 ft., From ... ft. to ... ft., From ... ft. to ... ft.
 What is the nearest source of possible contamination:
 1 Septic tank 4 Lateral lines 7 Pit privy 10 Livestock pens 14 Abandoned water well
 2 Sewer lines 5 Cess pool 8 Sewage lagoon 11 Fuel storage 15 Oil well/Gas well
 3 Watertight sewer lines 6 Seepage pit 9 Feedyard 12 Fertilizer storage 16 Other (specify below)
 13 Insecticide storage
 Direction from well? How many feet?

FROM	TO	LITHOLOGIC LOG	FROM	TO	PLUGGING INTERVALS
0'	6'	Silty clay, dark brown, silty, damp to moist, plastic. No odor.	30'	45'	Saturated, no odor. Sand, buff, medium to coarse grained, some fine gravel, fair sorting, some carbonate fragments.
6'	16'	Silty clay, medium brown, moist, plastic, trace carbonate fragments, no odor.	45'	45.5'	Weathered shale, dark gray, some gravel and carbonate fragments.
16'	18'	Silty clay, Brown. Moist, soft, slightly plastic, no odor.	45.5'	46'	Shale, dark gray, hard, blocky, semi-laminated.
18'	28'	Sand, light brown, fine to medium grained, sub-round to sub-angular, fair sorting, Saturated, no odor, silty lenses in upper zone.			
28'	30'	Silty clay, gray, sandy, soft,			

7 CONTRACTOR'S OR LANDOWNER'S CERTIFICATION: This water well was (1) constructed, (2) reconstructed, or (3) plugged under my jurisdiction and was completed on (mo/day/year) 6/12/03 and this record is true to the best of my knowledge and belief. Kansas Water Well Contractor's Licence No. 590 This Water Well Record was completed on (mo/day/yr) 7-30-03 under the business name of Liehs Drilling Inc. by (signature) W Liehs/eh.