

MW365

WATER WELL RECORD

Form WWC-5

KSA 82a-1212 ID No.

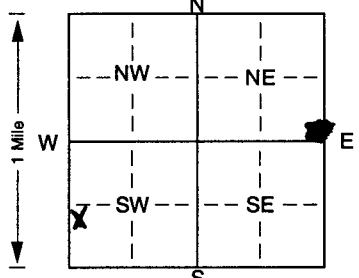
00317197

nw/sw/sw/nw

1) LOCATION OF WATER WELL: Fraction ~~1/4~~ ~~1/4~~ ~~1/4~~ Section Number ~~1~~ 3 Township Number T 14 S Range Number R 18 EW

Distance and direction from nearest town or city street address of well if located within city?
 703 Vine St. Hays, KS

2) WATER WELL OWNER: Mr. Quick Mini-Mart
 RR#, St. Address, Box #: 703 Vine St. Hays, KS 67601
 City, State, ZIP Code: Hays, KS 67601
 Board of Agriculture, Division of Water Resources
 Application Number:

3) LOCATE WELL'S LOCATION WITH AN "X" IN SECTION BOX:  DEPTH OF COMPLETED WELL: 32.5 ft. ELEVATION: Grand 1982.19
 Depth(s) Groundwater Encountered: 1. ft. 21982.8 ft. 3. ft.
 WELL'S STATIC WATER LEVEL: 21.27 ft. below land surface measured on mo/day/yr 6/16/03
 Pump test data: Well water was ... ft. after ... hours pumping ... gpm
 Est. Yield ... gpm: Well water was ... ft. after ... hours pumping ... gpm
 Bore Hole Diameter: 8 in. to 32.5 ft., and ... in. to ... ft.
 WELL WATER TO BE USED AS: 5 Public water supply 8 Air conditioning 11 Injection well
 1 Domestic 3 Feedlot 6 Oil field water supply 9 Dewatering 12 Other (Specify below)
 2 Irrigation 4 Industrial 7 Domestic (lawn & garden) 10 Monitoring well
 Was a chemical/bacteriological sample submitted to Department? Yes. No; If yes, mo/day/yrs sample was submitted Water Well Disinfected? Yes No

5) TYPE OF BLANK CASING USED: 1 Steel 3 RMP (SR) 5 Wrought iron 8 Concrete tile CASING JOINTS: Glued. Clamped. Welded. Threaded. X
 2 PVC 4 ABS 7 Fiberglass
 Blank casing diameter: 2 in. to 17.5 ft., Dia. in. to ... ft., Dia. in. to ... ft.
 Casing height above land surface: 0.09 in., weight ... lbs./ft. Wall thickness or gauge No. SCH 40
 TYPE OF SCREEN OR PERFORATION MATERIAL: 7 PVC 10 Asbestos-cement
 1 Steel 3 Stainless steel 5 Fiberglass 8 RMP (SR) 11 Other (specify) ...
 2 Brass 4 Galvanized steel 6 Concrete tile 9 ABS 12 None used (open hole)
 SCREEN OR PERFORATION OPENINGS ARE: 3 Mill slot 5 Gauzed wrapped 8 Saw cut 11 None (open hole)
 1 Continuous slot 4 Key punched 6 Wire wrapped 9 Drilled holes
 2 Louvered shutter 7 Torch cut 10 Other (specify) ... ft.
 SCREEN-PERFORATED INTERVALS: From 17.5 ft. to 32.5 ft., From ... ft. to ... ft.
 GRAVEL PACK INTERVALS: From 32.5 ft. to 15.5 ft., From ... ft. to ... ft.

6) GROUT MATERIAL: 1 Neat cement 2 Cement grout 3 Bentonite 4 Other
 Grout Intervals: From 13.5 ft. to 3 ft., From ... ft. to ... ft., From ... ft. to ... ft.
 What is the nearest source of possible contamination:
 1 Septic tank 4 Lateral lines 7 Pit privy 11 Fuel storage 14 Abandoned water well
 2 Sewer lines 5 Cess pool 8 Sewage lagoon 12 Fertilizer storage 15 Oil well/Gas well
 3 Watertight sewer lines 6 Seepage pit 9 Feedyard 13 Insecticide storage 16 Other (specify below)
 Direction from well? How many feet?

FROM	TO	LITHOLOGIC LOG	FROM	TO	PLUGGING INTERVALS
0	6	silty clay, dark brown, damp to moist, plastic no odor.	30'	32.5'	soft, saturated, no odor. Sand, buff, medium to coarse grained, some fine gravel, fair sorting, some carbonate fragments
6'	16'	Silty clay, medium brown, moist, plastic, trace carbonate fragments. No odor			
16'	18'	Silty clay, brown, moist soft, slightly plastic. No odor			
18'	28'	Sand, light brown, fine to medium gray, sub-round to sub-angular, fair sorting saturated, no odor, silty leaves in upper zone.			
28'	30'	Silty clay, gray, sandy,			

7) CONTRACTOR'S OR LANDOWNER'S CERTIFICATION: This water well was (1) constructed, (2) reconstructed, or (3) plugged under my jurisdiction and was completed on (mo/day/year) 6-12-03 and this record is true to the best of my knowledge and belief. Kansas Water Well Contractor's Licence No. 590 This Water Well Record was completed on (mo/day/yr) 7-30-03 under the business name of Rick's Drilling Inc. by (signature) W. Rick's/llh.

INSTRUCTIONS: Use typewriter or ball point pen. PLEASE PRESS FIRMLY and PRINT clearly. Please fill in blanks, underline or circle the correct answers. Send top three copies to Kansas Department of Health and Environment, Bureau of Water, Topeka, Kansas 66620-0001. Telephone 785-296-5524. Send one to WATER WELL OWNER and retain one for your records. Fee of \$5.00 for each constructed well.