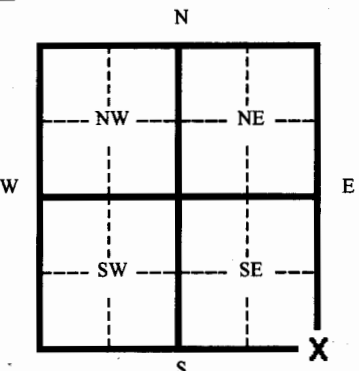


1 LOCATION OF WATER WELL:	Fraction	Section Number	Township Number	Range Number
County: Ellis	SE 1/4 SE 1/4 SE 1/4	24	14	18-West

Distance and direction from nearest town or city street address of well if located within city?

1899 Munjor Road, Munjor, Kansas


2 WATER WELL OWNER: Polly Pfannenstiel	Board of Agriculture, Division of Water Resources Application Number:
RR#, St. Address, Box # 1899 Munjor Road	
City, State, ZIP Code : Munjor, Kansas 67601	

3 MARK WELL'S LOCATION WITH AN "X" IN SECTION BOX:	4 DEPTH OF WELL 30.0 ft.
	WELL'S STATIC WATER LEVEL N/A ft. Well damaged; casing filled with dirt.
	WELL WAS USED AS:
	1 Domestic 5 Public Water Supply 9 Dewatering 2 Irrigation 6 Oil Field Water Supply 10 Monitoring Well 3 Feedlot 7 Lawn and Garden (domestic) 11 Injection Well 4 Industrial 8 Air Conditioning 12 Other _____
	Was a chemical/bacteriological sample submitted to Department? Yes ___ No X If yes, mo/day/yr sample was submitted _____ Water Well Disinfected: Yes ___ No X

5 TYPE OF BLANK CASING USED:
1 Steel 3 RMP (SR) 5 Wrought 7 Fiberglass 9 Other (specify below) 2 PVC 4 ABC 6 Asbestos-Cement 8 Concrete Tile
Blank casing diameter 2.375 in. Was casing pulled? Yes X No ___ If yes, how much? 30'
Casing height above or <u>below</u> land surface Unknown in. Overdrilled well to 20'

6 GROUT PLUG MATERIAL:	1 Neat cement	2 Cement grout	3 Bentonite	4 Other Soils
Grout Plug Intervals	From 15.0 ft. to 3.0 ft.	From 3.0 ft. to 0.0 ft.	From ___ ft. to ___ ft.	From ___ ft. to ___ ft.
What is the nearest source of possible contamination:	1 Septic tank 6 Seepage pit 11 Fuel storage (former) 16 Other (specify below) 2 Sewer lines 7 Pit privy 12 Fertilizer storage 3 Watertight sewer lines 8 Sewage lagoon 13 Insecticide storage 4 Lateral lines 9 Feedyard 14 Abandoned water well 5 Cess Pool 10 Livestock pens 15 Oil well/ Gas well			
Direction from well? West-Northwest	How many feet? 140			

FROM	TO	CODE	PLUGGING MATERIALS
0.0	3.0		Compacted soils
3.0	20.0		Bentonite chips

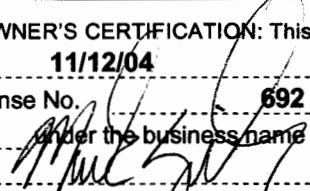7 CONTRACTOR'S OR LANDOWNER'S CERTIFICATION: This water well was plugged under my jurisdiction and was completed on (mo/day/yr) 11/12/04 and this record is true to the best of my knowledge and belief. Kansas Water Well Contractor's License No. 692 This Water Well Record was completed on (mo/day/yr) 12/03/04 under the business name of Quad State Services, Inc. by (signature) 
--

INSTRUCTIONS: Please fill in blanks and circle the correct answers. Send three copies to Kansas Department of Health and Environment, Bureau of Water, 1000 S W Jackson St., Ste. 420, Topeka, Kansas 66620-0001. Telephone: 785-296-3565. Send one to Water Well Owner and retain one for your records.