


WATER WELL RECORD Form WWC-5 KSA 82a-1212

1 LOCATION OF WATER WELL: County: <b>Ellis</b>	Fraction <b>NW ¼ SW ¼ NW ¼</b>	Section Number <b>3</b>	Township Number <b>T 14 S</b>	Range Number <b>R 18 E/W</b>
---	-----------------------------------	----------------------------	----------------------------------	---------------------------------

Distance and direction from nearest town or city street address of well if located within city?  
**1002 Vine Street, Hays**

2 WATER WELL OWNER: **City of Hays Service Dept.**  
 RR#, St. Address, Box # : **P.O. Box 490**  
 City, State, ZIP Code : **Hays, Kansas 67601**  
 Board of Agriculture, Division of Water Resources  
 Application Number:

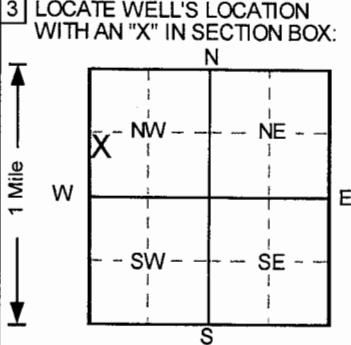

4 DEPTH OF COMPLETED WELL ..... **34** ..... ft ELEVATION: ..... **0** ..... ft  
 Depth(s) Groundwater Encountered 1. .... ft 2. .... ft 3. .... ft  
 WELL'S STATIC WATER LEVEL ..... ft below land surface measured on mo/day/yr  
 Pump test data: Well water was **NA** ft. after ..... hours pumping ..... gpm  
 Est. Yield **NA** gpm Well water was ..... ft after ..... hours pumping ..... gpm  
 Bore Hole Diameter ..... **6** ..... in. to ..... **34** ..... ft, and ..... in. to ..... ft  
 WELL WATER TO BE USED AS: 5 Public water supply 8 Air conditioning 11 Injection well  
 1 Domestic 3 Feedlot 6 Oil field water supply 9 Dewatering **12 Other (Specify below)**  
 2 Irrigation 4 Industrial 7 Lawn and garden only 10 Monitoring **Air sparge**  
 Was a chemical/bacteriological sample submitted to Department? Yes.....No ; If yes, mo/day/yr sample was submitted  
 Water Well Disinfected? Yes No

5 TYPE OF BLANK CASING USED:  
 1 Steel 3 RMP (SR) 5 Wrought iron 8 Concrete tile CASING JOINTS: Glued ..... Clamped .....  
**2 PVC** 4 ABS 6 Asbestos-Cement 9 Other (specify below) Welded .....  
 7 Fiberglass Threaded.   
 Blank casing diameter ..... **2** ..... in. to ..... **32** ..... ft, Dia ..... in. to ..... ft, Dia ..... in. to ..... ft  
 Casing height above land surface ..... **0** ..... in., weight ..... lbs./ft. Wall thickness or gauge No. .... **Sch. 40** .....  
 TYPE OF SCREEN OR PERFORATION MATERIAL  
 1 Steel 3 Stainless steel 5 Fiberglass **7 PVC** 10 Asbestos-cement  
 2 Brass 4 Galvanized steel 6 Concrete tile 8 RMP (SR) 11 Other (specify) .....  
 9 ABS 12 None used (open hole)  
 SCREEN OR PERFORATION OPENINGS ARE:  
 1 Continuous slot **3 Mill slot** 5 Gauzed wrapped 8 Saw cut 11 None (open hole)  
 2 Louvered shutter 4 Key punched 6 Wire wrapped 9 Drilled holes  
 7 Torch cut 10 Other (specify) .....  
 SCREEN-PERFORATED INTERVALS: From ..... **32** ..... ft to ..... **34** ..... ft, From ..... ft to ..... ft  
 From ..... ft to ..... ft, From ..... ft to ..... ft  
 GRAVEL PACK INTERVALS: From ..... **30** ..... ft to ..... **34** ..... ft, From ..... ft to ..... ft  
 From ..... ft to ..... ft, From ..... ft to ..... ft

6 GROUT MATERIAL: 1 Neat cement 2 Cement grout **3 Bentonite** 4 Other .....  
 Grout Intervals: From ..... **2** ..... ft to ..... **30** ..... ft, From ..... ft to ..... ft, From ..... ft to ..... ft  
 What is the nearest source of possible contamination:  
 1 Septic tank 4 Lateral lines 7 Pit privy 10 Livestock pens 14 Abandoned water well  
 2 Sewer lines 5 Cess pool 8 Sewage lagoon 11 Fuel storage 15 Oil well/Gas well  
 3 Watertight sewer lines 6 Seepage pit 9 Feedyard 12 Fertilizer storage **16 Other (specify below)**  
 From UST basin  
 Direction from well? How many feet? **0**

FROM	TO	LITHOLOGIC LOG	FROM	TO	PLUGGING INTERVALS
0	1	Gravel, clay,			
1	7	Clay, silty, plastic, Dark Brown			
7	13	Silt, clayey, sl. plastic, Brown			
13	23	Clay, v. silty, plastic, Brown to sl. Red Brown			
23	30	Clay, silty, tr. sand, Gray Green			
					AS4, Flushmount
					Project Name: GF - City of Hays Service Center
					GeoCore # 1154, KDHE # U6 026 00771

7 CONTRACTOR'S OR LANDOWNER'S CERTIFICATION: This water well was **(1)** constructed, (2) reconstructed, or (3) plugged under my jurisdiction and was completed on (mo/day/year) ..... **1/26/2005** ..... and this record is true to the best of my knowledge and belief.  
 Kansas Water Well Contractor's License No. .... **527** ..... This Water Well Record was completed on (mo/day/yr) ..... **1/31/05** .....  
 under the business name of **GeoCore, Inc.** by (signature) *Dale Kell*

OFFICE USE ONLY  
T  
R  
EWM  
SEC.  
1/4  
1/4  
1/4