


1] LOCATION OF WATER WELL: County: Ellis Fraction NW 1/4 SW 1/4 NW 1/4 Section Number 3 Township Number T 14 S Range Number R 18 E/W

Distance and direction from nearest town or city street address of well if located within city? 1002 Vine Street, Hays

2] WATER WELL OWNER: City of Hays Service Dept. RR#, St. Address, Box #: P.O. Box 490 City, State, ZIP Code: Hays, Kansas 67601 Board of Agriculture, Division of Water Resources Application Number:

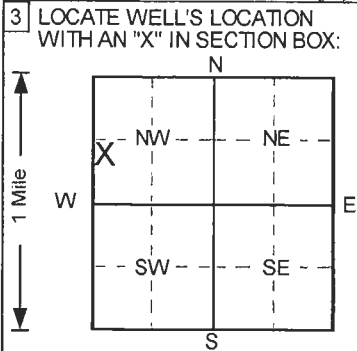

4] DEPTH OF COMPLETED WELL: 23 ft ELEVATION: 0. Depth(s) Groundwater Encountered 1. ft 2. ft 3. ft. WELL'S STATIC WATER LEVEL ft below land surface measured on mo/day/yr Pump test data: Well water was NA ft after hours pumping gpm Est. Yield NA gpm: Well water was ft after hours pumping gpm Bore Hole Diameter 8 in. to 23 ft, and in. to ft. WELL WATER TO BE USED AS: 5 Public water supply 8 Air conditioning 11 Injection well 12 Other (Specify below) 1 Domestic 3 Feedlot 6 Oil field water supply 9 Dewatering 10 Monitoring well 2 Irrigation 4 Industrial 7 Lawn and garden only 10 Monitoring well Soil vapor extraction Was a chemical/bacteriological sample submitted to Department? Yes No; If yes, mo/day/yr sample was submitted Water Well Disinfected? Yes No

5] TYPE OF BLANK CASING USED: 1 Steel 2 PVC 3 RMP (SR) 4 ABS 5 Wrought iron 6 Asbestos-Cement 7 Fiberglass 8 Concrete tile 9 Other (specify below) CASING JOINTS: Glued Clamped Welded Threaded. TYPE OF SCREEN OR PERFORATION MATERIAL: 1 Steel 2 Brass 3 Stainless steel 4 Galvanized steel 5 Fiberglass 6 Concrete tile 7 PVC 8 RMP (SR) 9 ABS 10 Asbestos-cement 11 Other (specify) 12 None used (open hole) SCREEN OR PERFORATION OPENINGS ARE: 1 Continuous slot 2 Louvered shutter 3 Mill slot 4 Key punched 5 Gauzed wrapped 6 Wire wrapped 7 Torch cut 8 Saw cut 9 Drilled holes 10 Other (specify) 11 None (open hole) SCREEN-PERFORATED INTERVALS: From 8 ft to 23 ft. GRAVEL PACK INTERVALS: From 7 ft to 23 ft.

6] GROUT MATERIAL: 1 Neat cement 2 Cement grout 3 Bentonite 4 Other Grout Intervals: From 2 ft to 7 ft. What is the nearest source of possible contamination: 1 Septic tank 2 Sewer lines 3 Watertight sewer lines 4 Lateral lines 5 Cess pool 6 Seepage pit 7 Pit privy 8 Sewage lagoon 9 Feedyard 10 Livestock pens 11 Fuel storage 12 Fertilizer storage 13 Insecticide storage 14 Abandoned water well 15 Oil well/Gas well 16 Other (specify below) Fmr. UST basin Direction from well? How many feet? 0

FROM	TO	LITHOLOGIC LOG	FROM	TO	PLUGGING INTERVALS
0	1	Gravelly Clay,			
1	7	Clay, silty, plastic, Dark Brown			
7	13	Silt, sl. clayey, sl. plastic,			
13	23	Clay, v. silty, plastic, Brown to sl. Red Brown			
					SVE4, Flushmount
					Project Name: GF - City of Hays Service Center
					GeoCore # 1154 , KDHE # U6 026 00771

7] CONTRACTOR'S OR LANDOWNER'S CERTIFICATION: This water well was (1) constructed, (2) reconstructed, or (3) plugged under my jurisdiction and was completed on (mo/day/year) 1/27/2005 and this record is true to the best of my knowledge and belief. Kansas Water Well Contractor's License No. 527. This Water Well Record was completed on (mo/day/yr) 1/23/05 under the business name of GeoCore, Inc. by (signature) Dale Bell

INSTRUCTIONS: Use typewriter or ball point pen. PLEASE PRESS FIRMLY and PRINT clearly. Please fill in blanks, underline or circle the correct answers. Send top three copies to Kansas Department of Health and Environment, Bureau of Water, Topeka, Kansas 66620-0001. Telephone: 913-296-5545. Send one to WATER WELL OWNER and retain one for your records.

OFFICE USE ONLY
T
R
EW
SEC.
1/4
1/4
1/4