

1 LOCATION OF WATER WELL:	Fraction	Section Number	Township Number	Range Number
County: Ellis	SW ¼ SE ¼ SE ¼	3	T 14 S	R 18 E W

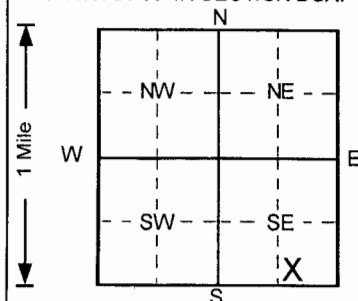
Distance and direction from nearest town or city street address of well if located within city?

180' E & 40' N of int. South St Dr. & Meadow, Hays2 WATER WELL OWNER: **Pepsi Cola Bottling**RR#, St. Address, Box # : **PO Box 460**City, State, ZIP Code : **Hays, Kansas 67601**

Board of Agriculture, Division of Water Resources

Application Number:

3 LOCATE WELL'S LOCATION WITH AN "X" IN SECTION BOX:

4 DEPTH OF COMPLETED WELL: **85** ft. ELEVATION:

Depth(s) Groundwater Encountered 1. ft. 2. ft. 3. ft.

WELL'S STATIC WATER LEVEL ... **46.9** ... ft. below land surface measured on mo/day/yr ... **5/3/2005** ...Pump test data: Well water was ... **NA** ... ft. after ... hours pumping ... gpmEst. Yield ... **NA** ... gpm: Well water was ... ft. after ... hours pumping ... gpmBore Hole Diameter ... **8** ... in. to ... **85** ... ft. and ... in. to ... ft.

WELL WATER TO BE USED AS: 5 Public water supply 8 Air conditioning 11 Injection well

1 Domestic 3 Feedlot 6 Oil field water supply 9 Dewatering 12 Other (Specify below)

2 Irrigation 4 Industrial 7 Lawn and garden only **10 Monitoring well**Was a chemical/bacteriological sample submitted to Department? Yes.....No ☒..... If yes, mo/day/yr sample was submitted Water Well Disinfected? Yes No ☒

5 TYPE OF BLANK CASING USED:

1 Steel

3 RMP (SR)

5 Wrought iron

8 Concrete tile

CASING JOINTS: Glued Clamped

2 PVC

4 ABS

6 Asbestos-Cement

9 Other (specify below)

Welded

Blank casing diameter ... **2** ... in. to ... **75** ... ft. Dia ... in. to ... ft. Dia ... in. to ... ft.Casing height above land surface ... **30** ... in., weight ... lbs./ft. Wall thickness or gauge No. ... **Sch. 40** ...

TYPE OF SCREEN OR PERFORATION MATERIAL

1 Steel

3 Stainless steel

5 Fiberglass

7 PVC

10 Asbestos-cement

2 Brass

4 Galvanized steel

6 Concrete tile

8 RMP (SR)

11 Other (specify)

SCREEN OR PERFORATION OPENINGS ARE:

1 Continuous slot

3 Mill slot

5 Gauzed wrapped

8 Saw cut

11 None (open hole)

2 Louvered shutter

4 Key punched

6 Wire wrapped

9 Drilled holes

SCREEN-PERFORATED INTERVALS: From ... **75** ... ft. to ... **85** ... ft. From ... ft. to ... ft. From ... ft. to ... ft.GRAVEL PACK INTERVALS: From ... **70** ... ft. to ... **85** ... ft. From ... ft. to ... ft. From ... ft. to ... ft.

6 GROUT MATERIAL:

1 Neat cement

2 Cement grout**3 Bentonite****4 Other Native soil**Grout intervals: From ... **0** ... ft. to ... **21** ... ft. From ... **21** ... ft. to ... **30** ... ft. From ... **30** ... ft. to ... **70** ... ft.

What is the nearest source of possible contamination:

1 Septic tank

4 Lateral lines

7 Pit privy

10 Livestock pens

14 Abandoned water well

2 Sewer lines

5 Cess pool

8 Sewage lagoon

11 Fuel storage

15 Oil well/Gas well

3 Watertight sewer lines

6 Seepage pit

9 Feedyard

12 Fertilizer storage

16 Other (specify below)Direction from well? **North**

13 Insecticide storage

... **Emr UST basin** ...How many feet? **670**

FROM	TO	LITHOLOGIC LOG	FROM	TO	PLUGGING INTERVALS
0	2	Clay, silty, moist, plastic, Brown			
2	13	Clay, very silty, occ. white calc. clasts, V. Lt. B			
13	31	Clay, v. silty, moist, plastic, white calc. mat., L			
31	41	Silt, sl. moist, loose, Lt. Brown			
41	48	Silt, moist, saturated at 46', Brown			
48	52	Sand (f), subrounded, saturated, Brown			
52	66	Silt, sandy, sl. clayey, saturated, Lt. Brown			
66	71	Clay, silty, sl. sandy, very moist to saturated,			
71	82	Sand (f), rounded, saturated, no odor, Lt. Bro			
82	84	Reworked shale,			
84	85	Shale, firm, Bluish Gray			
					MW16D, Tag # 00362890, Abovegrade
					Project Name: Pepsi-Cola Bottling Company - Remedial
					GeoCore # 708, KDHE # U6 026 00066B

7 CONTRACTOR'S OR LANDOWNER'S CERTIFICATION: This water well was **(1)** constructed, **(2)** reconstructed, or **(3)** plugged under my jurisdiction and was completed on (mo/day/year) ... **5/2/2005** ... and this record is true to the best of my knowledge and belief.Kansas Water Well Contractor's License No. ... **527** ... This Water Well Record was completed on (mo/day/yr) ... **5/9/2005** ...

under the business name of

GeoCore, Inc.by (signature) *Dale Bell*