


1 LOCATION OF WATER WELL: County: **Ellis** Fraction: **SW 1/4 SE 1/4 SE 1/4** Section Number: **3** Township Number: **T 14 S** Range Number: **R 18 E W**

Distance and direction from nearest town or city street address of well if located within city?
80' W & 40' N of int. South St Dr. & Meadow, Hays

2 WATER WELL OWNER: **Pepsi Cola Bottling**
 RR#, St. Address, Box #: **PO Box 460** Board of Agriculture, Division of Water Resources
 City, State, ZIP Code: **Hays, Kansas 67601** Application Number:

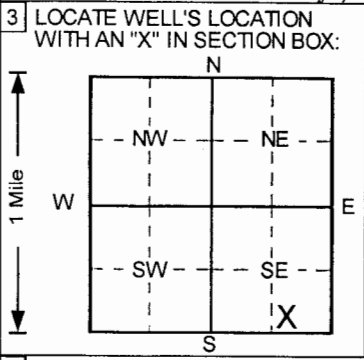

4 DEPTH OF COMPLETED WELL: **78.5** ft. ELEVATION:
 Depth(s) Groundwater Encountered 1. ft. 2. ft. 3. ft.
 WELL'S STATIC WATER LEVEL: **41.5** ft. below land surface measured on **mo/day/yr** **5/4/2005**
 Pump test data: Well water was **NA** ft. after hours pumping gpm
 Est. Yield **NA** gpm: Well water was ft. after hours pumping gpm
 Bore Hole Diameter: **8** in. to **78.5** ft., and in. to ft.
 WELL WATER TO BE USED AS:
 5 Public water supply 8 Air conditioning 11 Injection well
 1 Domestic 3 Feedlot 6 Oil field water supply 9 Dewatering 12 Other (Specify below)
 2 Irrigation 4 Industrial 7 Lawn and garden only **10** Monitoring well
 Was a chemical/bacteriological sample submitted to Department? Yes.....No; If yes, mo/day/yr sample was submitted
 Water Well Disinfected? Yes No

5 TYPE OF BLANK CASING USED:
 1 Steel 3 RMP (SR) 5 Wrought iron 8 Concrete tile CASING JOINTS: Glued Clamped
2 PVC 4 ABS 6 Asbestos-Cement 9 Other (specify below) Welded
 Blank casing diameter: **2** in. to **68.5** ft., Dia. in. to ft., Dia. in. to ft.
 Casing height above land surface: **24** in., weight lbs./ft. Wall thickness or gauge No. **Sch. 40**
 TYPE OF SCREEN OR PERFORATION MATERIAL
 1 Steel 3 Stainless steel 5 Fiberglass **7** PVC 10 Asbestos-cement
 2 Brass 4 Galvanized steel 6 Concrete tile 8 RMP (SR) 11 Other (specify)
 12 None used (open hole)
 SCREEN OR PERFORATION OPENINGS ARE:
 1 Continuous slot **3** Mill slot 5 Gauzed wrapped 8 Saw cut 11 None (open hole)
 2 Louvered shutter 4 Key punched 6 Wire wrapped 9 Drilled holes
 7 Torch cut 10 Other (specify)
 SCREEN-PERFORATED INTERVALS: From **68.5** ft. to **78.5** ft., From ft. to ft.
 From ft. to ft., From ft. to ft.
 GRAVEL PACK INTERVALS: From **65** ft. to **78.5** ft., From ft. to ft.
 From ft. to ft., From ft. to ft.

6 GROUT MATERIAL: 1 Neat cement **2** Cement grout **3** Bentonite **4** Other **Native soil**
 Grout Intervals: From **0** ft. to **30** ft., From **30** ft. to **34** ft., From **34** ft. to **65.5** ft.
 What is the nearest source of possible contamination:
 1 Septic tank 4 Lateral lines 7 Pit privy 10 Livestock pens 14 Abandoned water well
 2 Sewer lines 5 Cess pool 8 Sewage lagoon 11 Fuel storage 15 Oil well/Gas well
 3 Watertight sewer lines 6 Seepage pit 9 Feedyard 12 Fertilizer storage **16** Other (specify below)
 13 Insecticide storage **Emr. UST basin**
 Direction from well? **NNE** How many feet? **690**

FROM	TO	LITHOLOGIC LOG	FROM	TO	PLUGGING INTERVALS
0	5	Clay, silty, Lt. Brown			
5	14	Clay, silty, tr. vf sand, dry, white calc. clasts,			
14	18	Clay, silty, stiff, white calc. clasts, Lt. Brown			
18	30	Clay, silty, firm, moist, plastic, Lt. Brown			
30	34	Sand (vf), silty, dry, Tan			
34	40	Silt, clayey, moist, Brown			
40	44	Clay, silty, moist, tr. vf sand, Brown			
44	77.5	Sand (f-m), tr. silt, saturated,			
77.5	78.5	Shale,			
					MW15D, Tag # 00362876, Abovegrade
					Project Name: Pepsi-Cola Bottling Company - Remedial
					GeoCore # 708, KDHE # U6 026 00066B

7 CONTRACTOR'S OR LANDOWNER'S CERTIFICATION: This water well was **(1)** constructed, (2) reconstructed, or (3) plugged under my jurisdiction and was completed on (mo/day/year) **5/3/2005** and this record is true to the best of my knowledge and belief.
 Kansas Water Well Contractor's License No. **527** This Water Well Record was completed on (mo/day/yr) **5/9/2005**
 under the business name of **GeoCore, Inc.** by (signature) *Dale Raloff*

INSTRUCTIONS: Use typewriter or ball point pen. PLEASE PRESS FIRMLY and PRINT clearly. Please fill in blanks, underline or circle the correct answers. Send top three copies to Kansas Department of Health and Environment, Bureau of Water, Topeka, Kansas 66620-0001. Telephone: 913-296-5545. Send one to WATER WELL OWNER and retain one for your records.

OFFICE USE ONLY
T
R
EM
SEC
1/4
1/4
1/4