


1 LOCATION OF WATER WELL: County: <b>Ellis</b>	Fraction <b>SE 1/4 SE 1/4 NE 1/4</b>	Section Number <b>4</b>	Township Number <b>T 14 S</b>	Range Number <b>R 18 <span style="border: 1px solid black; border-radius: 50%; padding: 2px;">EW</span></b>
---	---	----------------------------	----------------------------------	--

Distance and direction from nearest town or city street address of well if located within city?

**801 S. Vine St., Hays**

2 WATER WELL OWNER: <b>Home Oil</b> RR#, St. Address, Box # : <b>P.O. Box 673</b> City, State, ZIP Code : <b>Hays, KS 67601</b>	Board of Agriculture, Division of Water Resources Application Number:
---	--

3 LOCATE WELL'S LOCATION WITH AN "X" IN SECTION BOX:

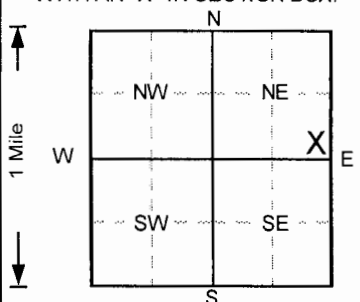

4 DEPTH OF COMPLETED WELL: **20** ft. ELEVATION: **0**

Depth(s) Groundwater Encountered 1. . . . . ft. 2. . . . . ft. 3. . . . . ft.

WELL'S STATIC WATER LEVEL . . . . . ft. below land surface measured on mo/day/yr . . . . .

Pump test data: Well water was **NA** ft. after . . . . . hours pumping . . . . . gpm

Est. Yield **NA** gpm: Well water was . . . . . ft. after . . . . . hours pumping . . . . . gpm

Bore Hole Diameter **8.25** in. to **20** ft., and . . . . . in. to . . . . . ft.

WELL WATER TO BE USED AS: 5 Public water supply 8 Air conditioning 11 Injection well  
1 Domestic 3 Feedlot 6 Oil field water supply 9 Dewatering 12 Other (Specify below)  
2 Irrigation 4 Industrial 7 Lawn and garden only **10** Monitoring well

Was a chemical/bacteriological sample submitted to Department? Yes . . . . . No  ; If yes, mo/day/yr sample was submitted

Water Well Disinfected? Yes . . . . . No

5 TYPE OF BLANK CASING USED:

1 Steel	3 RMP (SR)	5 Wrought iron	8 Concrete tile	CASING JOINTS: Glued . . . . . Clamped . . . . .	
<b>2</b> PVC	4 ABS	6 Asbestos-Cement	9 Other (specify below)	Welded . . . . .	
		7 Fiberglass	Threaded. <input checked="" type="checkbox"/>		

Blank casing diameter . . . . . **4** in. to . . . . . **10** ft., Dia . . . . . in. to . . . . . ft., Dia . . . . . in. to . . . . . ft.

Casing height above land surface . . . . . **0** in., weight . . . . . lbs./ft. Wall thickness or gauge No. **Sch. 40**

TYPE OF SCREEN OR PERFORATION MATERIAL

1 Steel	3 Stainless steel	5 Fiberglass	<b>7</b> PVC	10 Asbestos-cement
2 Brass	4 Galvanized steel	6 Concrete tile	8 RMP (SR)	11 Other (specify) . . . . .
12 None used (open hole)				

SCREEN OR PERFORATION OPENINGS ARE:

1 Continuous slot	<b>3</b> Mill slot	5 Gauzed wrapped	8 Saw cut	11 None (open hole)
2 Louvered shutter	4 Key punched	6 Wire wrapped	9 Drilled holes	10 Other (specify) . . . . .
7 Torch cut				

SCREEN-PERFORATED INTERVALS: From . . . . . **10** ft. to . . . . . **20** ft., From . . . . . ft. to . . . . . ft.

GRAVEL PACK INTERVALS: From . . . . . **8** ft. to . . . . . **20** ft., From . . . . . ft. to . . . . . ft.

6 GROUT MATERIAL: 1 Neat cement **2** Cement grout **3** Bentonite 4 Other . . . . .

Grout Intervals: From . . . . . **0** ft. to . . . . . **2** ft., From . . . . . **2** ft. to . . . . . **8** ft., From . . . . . ft. to . . . . . ft.

What is the nearest source of possible contamination:

1 Septic tank	4 Lateral lines	7 Pit privy	10 Livestock pens	14 Abandoned water well
2 Sewer lines	5 Cess pool	8 Sewage lagoon	11 Fuel storage	15 Oil well/Gas well
3 Watertight sewer lines	6 Seepage pit	9 Feedyard	12 Fertilizer storage	<b>16</b> Other (specify below)
			13 Insecticide storage	<b>16</b> Fmr. UST basin . . . . .

Direction from well? **NE** How many feet? **42**

FROM	TO	LITHOLOGIC LOG	FROM	TO	PLUGGING INTERVALS
0	0.5	Concrete,			
0.5	1	Fill Sand,			
1	7	Clay, sl. silty, plastic, mod. "varnish" odor, Gr			
7	18	Clay, v. silty, plastic, sl. varnish odor, Lt. Gray			
18	20	Clay and Silt, sandy, mod. odor, Lt. Gray			

7 CONTRACTOR'S OR LANDOWNER'S CERTIFICATION: This water well was <b>(1)</b> constructed, (2) reconstructed, or (3) plugged under my jurisdiction and was completed on (mo/day/year) . . . . . <b>8/2/2005</b> . . . . . and this record is true to the best of my knowledge and belief.	Kansas Water Well Contractor's License No. <b>527</b> . . . . . This Water Well Record was completed on (mo/day/yr) . . . . . <b>8/19/05</b> . . . . . under the business name of <b>GeoCore, Inc.</b> by (signature) <i>Dale G. Bell</i>
<div style="text-align: right;"> <b>VEW3 , Flushmount</b>  <b>Project Name: GF - Howard's Service</b>  <b>GeoCore # 1162 , KDHE # U6 026 12404</b> </div>	