


1 LOCATION OF WATER WELL: County: Ellis Fraction: SE 1/4 NE 1/4 Section Number: 4 Township Number: T 14 S Range Number: R 18 E/W

Distance and direction from nearest town or city street address of well if located within city? 801 S. Vine St., Hays

2 WATER WELL OWNER: Home Oil RR#, St. Address, Box #: P.O. Box 673 City, State, ZIP Code: Hays, KS 67601 Board of Agriculture, Division of Water Resources Application Number:

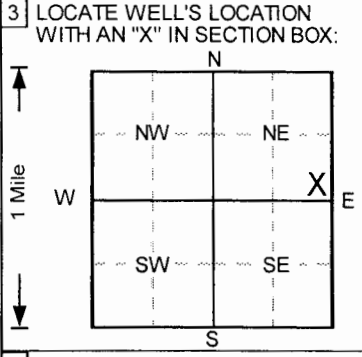

3 LOCATE WELL'S LOCATION WITH AN "X" IN SECTION BOX: 4 DEPTH OF COMPLETED WELL: 37.5 ft. ELEVATION: 0 ft. WELL'S STATIC WATER LEVEL: 0 ft. below land surface... Pump test data: Well water was NA ft. after... hours pumping... gpm...

5 TYPE OF BLANK CASING USED: 1 Steel, 2 PVC, 3 RMP (SR), 4 ABS, 5 Wrought iron, 6 Asbestos-Cement, 7 Fiberglass, 8 Concrete tile, 9 Other (specify below), 10 Asbestos-cement, 11 Injection well, 12 Other (Specify below). Casing diameter: 2 in. to 35 ft. Dia. Casing height above land surface: 0 in., weight... lbs./ft. Wall thickness or gauge No. Sch. 40. TYPE OF SCREEN OR PERFORATION MATERIAL: 1 Steel, 2 Brass, 3 Stainless steel, 4 Galvanized steel, 5 Fiberglass, 6 Concrete tile, 7 PVC, 8 RMP (SR), 9 ABS, 10 Asbestos-cement, 11 Other (specify), 12 None used (open hole). SCREEN OR PERFORATION OPENINGS ARE: 1 Continuous slot, 2 Louvered shutter, 3 Mill slot, 4 Key punched, 5 Gauzed wrapped, 6 Wire wrapped, 7 Torch cut, 8 Saw cut, 9 Drilled holes, 10 Other (specify), 11 None (open hole). SCREEN-PERFORATED INTERVALS: From 35 ft. to 37.5 ft. GRAVEL PACK INTERVALS: From 33 ft. to 39 ft.

6 GROUT MATERIAL: 1 Neat cement, 2 Cement grout, 3 Bentonite, 4 Other. Grout Intervals: From 0 ft. to 3 ft., From 3 ft. to 33 ft. What is the nearest source of possible contamination: 1 Septic tank, 2 Sewer lines, 3 Watertight sewer lines, 4 Lateral lines, 5 Cess pool, 6 Seepage pit, 7 Pit privy, 8 Sewage lagoon, 9 Feedyard, 10 Livestock pens, 11 Fuel storage, 12 Fertilizer storage, 13 Insecticide storage, 14 Abandoned water well, 15 Oil well/Gas well, 16 Other (specify below) Fmr: UST basin. Direction from well? NE How many feet? 35

Table with columns: FROM, TO, LITHOLOGIC LOG, FROM, TO, PLUGGING INTERVALS. Rows: 0 to 0.5 Concrete, 0.5 to 1 Sand, 1 to 7 Clay, sl. silty, plastic, "varnish" odor, Gray, 7 to 18 Clay, v. silty, plastic, sl. "varnish" odor, Lt. G, 18 to 25 Clay, v. silty grading to clayey silt, sandy, Lt., 25 to 30 Sand (vf-c), subrounded, strong odor, Gray, 30 to 39 Sand (f-c) w/fine gravel, subrounded, Grayish. IW5, Flushmount. Project Name: GF - Howard's Service. GeoCore # 1162, KDHE # U6 026 12404

7 CONTRACTOR'S OR LANDOWNER'S CERTIFICATION: This water well was (1) constructed, (2) reconstructed, or (3) plugged under my jurisdiction and was completed on (mo/day/year) 8/2/2005 and this record is true to the best of my knowledge and belief. Kansas Water Well Contractor's License No. 527. This Water Well Record was completed on (mo/day/yr) 8/9/05 under the business name of GeoCore, Inc. by (signature) Dale [Signature]

INSTRUCTIONS: Use typewriter or ball point pen. PLEASE PRESS FIRMLY and PRINT clearly. Please fill in blanks, underline or circle the correct answers. Send top three copies to Kansas Department of Health and Environment, Bureau of Water, Topeka, Kansas 66620-0001. Telephone: 913-296-5545. Send one to WATER WELL OWNER and retain one for your records.