


SHMW-8

WATER WELL PLUGGING RECORD Form WWC-5P KSA 82a-1212 ID NO. 00050739

1 LOCATION OF WATER WELL:	Fraction	Section Number	Township Number	Range Number
County: <u>Ellis</u>	<u>NE 1/4 SE 1/4 SE 1/4 NE</u>	<u>4</u>	<u>14</u>	<u>18</u> EW

Distance and direction from nearest town or city street address of well if located within city?
West of 8th and Vine 350', Hays, KS

2 WATER WELL OWNER: <u>KDHE</u>	Board of Agriculture, Division of Water Resources
RR #, St. Address, Box #: <u>1000 SW Jackson, Ste 410</u>	Application Number:
City, State, ZIP Code: <u>Topeka KS 66612</u>	

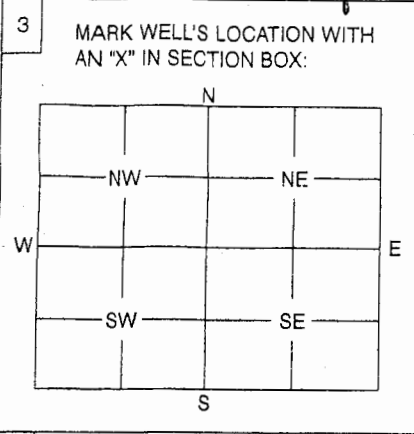

4 DEPTH OF WELL <u>35</u> ft.	9 Dewatering
WELL'S STATIC WATER LEVEL <u>22</u> ft.	10 Monitoring Well
WELL WAS USED AS:	11 Injection Well
1 Domestic	12 Other
2 Irrigation	
3 Feedlot	
4 Industrial	
5 Public Water Supply	
6 Oil Field Water Supply	
7 Domestic (Lawn & Garden)	
8 Air Conditioning	

Was a chemical / bacteriological sample submitted to Department? Yes No X.....
 If yes, mo/day/yr sample was submitted

Water Well Disinfected: Yes No X.....

5 TYPE OF BLANK CASING USED:

1 Steel	3 RMP (SR)	5 Wrought	7 Fiberglass	9 Other (Specify below)
<u>2 PVC</u>	4 ABS	6 Asbestos-Cement	8 Concrete Tile	

Blank casing diameter 2 in. Was casing pulled? Yes X No If yes, how much 3'
 Casing height above or below land surface in.

6 GROUT PLUG MATERIAL: 1 Neat cement 2 Cement grout 3 Bentonite 4 Other

Grout Plug Intervals: From 3 ft. to 35 ft., From ft. to ft., From to ft.

What is the nearest source of possible contamination:

1 Septic tank	6 Seepage pit	11 Fuel storage	16 Other (specify below)
2 Sewer lines	7 Pit privy	12 Fertilizer storage	
3 Watertight sewer lines	8 Sewage lagoon	13 Insecticide storage	
4 Lateral lines	9 Feedyard	14 Abandoned water well	
5 Cess pool	10 Livestock pens	15 Oil well/Gas well	

Direction from well? How many feet?

FROM	TO	PLUGGING MATERIALS
<u>35'</u>	<u>3'</u>	<u>Bentonite chips</u>
<u>3'</u>	<u>0'</u>	<u>Native material</u>

7 CONTRACTOR'S OF LANDOWNER'S CERTIFICATION: This water well was plugged under my jurisdiction and was completed on (mo/day/year) 3-31-10 and this record is true to the best of my knowledge and belief. Kansas Water Well Contractor's License No. 4-26-10 This Water Well Record was completed on (mo/day/year) 4-26-10 under the business name of GreenField Contractors by (signature) Jan Pearson

INSTRUCTIONS: Use typewriter or ball point pen. Please press firmly and print clearly. Please fill in blanks, underline or circle the correct answers. Send top three copies to Kansas Department of Health and Environment, Bureau of Water, Geology Section, 1000 SW Jackson St., Ste. 420, Topeka, Kansas 66612-1367. Telephone: 785/296-5522. Send one to Water Well Owner and retain one for your records.