


UEW-5

1	LOCATION OF WATER WELL:	Fraction	Section Number	Township Number	Range Number
	County: <u>Ellis</u>	<u>NE 1/4 SE 1/4 SE 1/4 NE</u>	<u>4</u>	<u>14</u>	<u>18</u> <small>EAD</small>

Distance and direction from nearest town or city street address of well if located within city?
801 S. Vine Street Hays, KS 67601

2	WATER WELL OWNER: <u>Home Oil</u>	Board of Agriculture, Division of Water Resources
	RR #, St. Address, Box #: <u>P.O. Box 673</u>	Application Number:
	City, State, ZIP Code: <u>Hays KS 67601</u>	

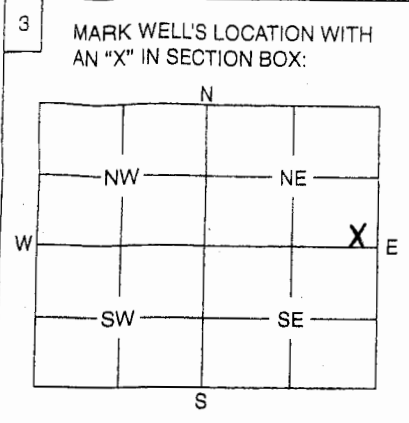

4	DEPTH OF WELL <u>19</u> ft.	
	WELL'S STATIC WATER LEVEL <u>N/A</u> ft.	
WELL WAS USED AS:		
1 Domestic	5 Public Water Supply	9 Dewatering
2 Irrigation	6 Oil Field Water Supply	10 Monitoring Well
3 Feedlot	7 Domestic (Lawn & Garden)	11 Injection Well
4 Industrial	8 Air Conditioning	12 Other <u>SUE</u>
Was a chemical / bacteriological sample submitted to Department? Yes No <u>X</u>		
If yes, mo/day/yr sample was submitted		
Water Well Disinfected: Yes No <u>X</u>		

5 TYPE OF BLANK CASING USED:

1 Steel	3 RMP (SR)	5 Wrought	7 Fiberglass	9 Other (Specify below)
2 PVC	4 ABS	6 Asbestos-Cement	8 Concrete Tile	

Blank casing diameter 4 in. Was casing pulled? Yes X No If yes, how much 3'

Casing height above or below land surface 36 in.

6 GROUT PLUG MATERIAL: 1 Neat cement 2 Cement grout 3 Bentonite 4 Other

Grout Plug Intervals: From 19 ft. to 3 ft., From ft. to ft., From to ft.

What is the nearest source of possible contamination:

1 Septic tank	6 Seepage pit	11 Fuel storage	16 Other (specify below)
2 Sewer lines	7 Pit privy	12 Fertilizer storage	
3 <u>Watertight sewer lines</u>	8 Sewage lagoon	13 Insecticide storage	
4 Lateral lines	9 Feedyard	14 Abandoned water well	
5 Cess pool	10 Livestock pens	15 Oil well/Gas well	

Direction from well? NW How many feet? 30

FROM	TO	PLUGGING MATERIALS
<u>19'</u>	<u>3'</u>	<u>Bentonite chips</u>
<u>3'</u>	<u>0'</u>	<u>Native material</u>

7 CONTRACTOR'S OF LANDOWNER'S CERTIFICATION: This water well was plugged under my jurisdiction and was completed on (mo/day/year) 3-31-10 and this record is true to the best of my knowledge and belief. Kansas Water Well Contractor's License No. This Water Well Record was completed on (mo/day/year) 4-16-10 under the business name of Green Field Contractors, Inc. by (signature) Jan Peckham