


1 LOCATION OF WATER WELL: County: Ellis Fraction NW 1/4 NW 1/4 NW 1/4 Section Number 2 Township Number T14 Range Number R18 E/W

Distance and direction from nearest town or city street address of well if located within city?

2000 E. 13th St Hays, KS 67601

2 WATER WELL OWNER: Hays Thrift Store Global Positioning Systems (decimal degrees, min. of 4 digits)
 RR#, St. Address, Box #: 2000 E. 13th St. Latitude: _____
 City, State ZIP Code: Hays, KS 67601 Longitude: _____
 Elevation: _____
 Datum: _____
 Data Collection Method: _____

3 MARK WELL'S LOCATION WITH AN "X" IN SECTION BOX:

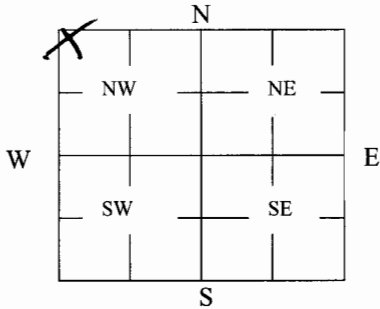

4 DEPTH OF WELL 28.25 ft.

WELL'S STATIC WATER LEVEL 24.83 ft

WELL WAS USED AS:

- 1 Domestic
- 2 Irrigation
- 3 Feedlot
- 4 Industrial
- 5 Public Water Supply
- 6 Oil Field Water Supply
- 7 Domestic (Lawn & Garden)
- 8 Air Conditioning
- 9 Dewatering
- 10 Monitoring
- 11 Injection Well
- 12 Other _____

Was a chemical bacteriological sample submitted to Department? Yes X No 8

5 TYPE OF BLANK CASING USED:
 1 Steel 2 PVC 3 RMP (SR) 4 ABS 5 Wrought 6 Asbestos-Cement 7 Fiberglass 8 Concrete Tile 9 Other (Specify below) _____

Blank casing diameter 2 in. Was casing pulled? Yes X No _____ If yes, how much 3'
 Casing height above or below land surface 5 in.

6 GROUT PLUG MATERIAL: 1 Neat cement 2 Cement grout 3 Bentonite 4 Other _____

Grout Plug Intervals: From 1.5 ft. to 28.25 ft., From _____ ft. to _____ ft., From _____ to _____ ft.

What is the nearest source of possible contamination:

- 1 Septic tank
 - 2 Sewer lines
 - 3 Watertight sewer lines
 - 4 Lateral lines
 - 5 Cess pool
 - 6 Seepage pit
 - 7 Pit privy
 - 8 Sewage lagoon
 - 9 Feedyard
 - 10 Livestock pens
 - 11 Fuel Storage
 - 12 Fertilizer storage
 - 13 Insecticide storage
 - 14 Abandoned water well
 - 15 Oil well/Gas well
 - 16 Other (specify below) _____
- Direction from well? _____
 How many feet? _____

FROM	TO	PLUGGING MATERIALS	FROM	TO	PLUGGING MATERIALS
<u>0</u>	<u>0.5</u>	<u>Concrete / Sand</u>			
<u>0.5</u>	<u>28.2</u>	<u>Bentonite Chips</u>			

7 CONTRACTOR'S OR LANDOWNER'S CERTIFICATION: This water well was plugged under my jurisdiction and was completed on (mo/day/year) 2/18/2010 and this record is true to the best of my knowledge and belief. Kansas Water Well Contractor's License No. _____. This Water Well Record was completed on (mo/day/year) 4/16/2010 under the business name of Environmental Remediate by (signature) [Signature]

INSTRUCTIONS: Use typewriter or ballpoint pen. Please press firmly and print clearly. Please fill in blanks, underline or circle the correct answers. Send top three copies to Kansas Department of Health and Environment, Bureau of Water, Geology Section, 1000 SW Jackson St., Ste. 420, Topeka, Kansas 66612-1367. Telephone: 785/296-5522. Send one to Water Well Owner and retain one for your records. Visit us at <http://www.kdheks.gov/geo/waterwells>.