


1 LOCATION OF WATER WELL: County: Rawl Fraction: NW 1/4 NW 1/4 NW 1/4 Section Number: 2 Township Number: T 14 S Range Number: R 18 EW

Distance and direction from nearest town or city street address of well if located within city?  
In town

2 WATER WELL OWNER: McCubbin Oil  
RR#, St. Address, Box #: 124 E. Main  
City, State, ZIP Code: Pretty Prairie, Ks.  
Board of Agriculture, Division of Water Resources  
Application Number:

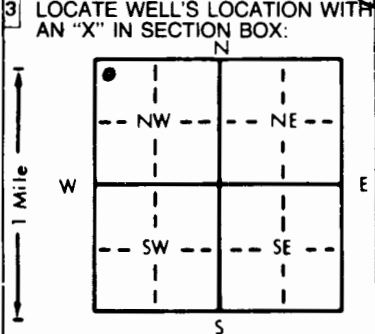

4 DEPTH OF COMPLETED WELL: 22' ft. ELEVATION:  
Depth(s) Groundwater Encountered: 1. 1' ft. 2. 1' ft. 3. 1' ft.  
WELL'S STATIC WATER LEVEL: 1' ft. below land surface measured on mo/day/yr 1'  
Pump test data: Well water was 1' ft. after 1' hours pumping 1' gpm  
Est. Yield 1' gpm: Well water was 1' ft. after 1' hours pumping 1' gpm  
Bore Hole Diameter: 10 1/2" in. to 22" in. to 1' ft.  
WELL WATER TO BE USED AS:  
5 Public water supply 8 Air conditioning 11 Injection well  
1 Domestic 3 Feedlot 6 Oil field water supply 9 Dewatering 12 Other (Specify below) SVE well  
2 Irrigation 4 Industrial 7 Lawn and garden only 10 Monitoring well  
Was a chemical/bacteriological sample submitted to Department? Yes X No X; If yes, mo/day/yr sample was submitted  
Water Well Disinfected? Yes No

5 TYPE OF BLANK CASING USED:  
1 Steel 3 RMP (SR) 5 Wrought iron 8 Concrete tile CASING JOINTS: Glued X Clamped X  
2 Brass 4 ABS 6 Asbestos-Cement 9 Other (specify below) Welded X  
7 Fiberglass Threaded X  
Blank casing diameter: 4.0 in. to 7' ft., Dia 4.0 in. to 7' ft., Dia 4.0 in. to 7' ft.  
Casing height above land surface: 3' in., weight 3' lbs./ft. Wall thickness or gauge No. SDR-13 Sch 40  
TYPE OF SCREEN OR PERFORATION MATERIAL:  
1 Steel 3 Stainless steel 5 Fiberglass 8 RMP (SR) 10 Asbestos-cement  
2 Brass 4 Galvanized steel 6 Concrete tile 9 ABS 11 Other (specify) 7 PVC  
12 None used (open hole)  
SCREEN OR PERFORATION OPENINGS ARE:  
1 Continuous slot 3 Mill slot 5 Gauzed wrapped 8 Saw cut 11 None (open hole)  
2 Louvered shutter 4 Key punched 6 Wire wrapped 9 Drilled holes  
SCREEN-PERFORATED INTERVALS: From 22' ft. to 7' ft., From 22' ft. to 7' ft., From 22' ft. to 7' ft.  
GRAVEL PACK INTERVALS: From 22' ft. to 6' ft., From 22' ft. to 6' ft., From 22' ft. to 6' ft.

6 GROUT MATERIAL: 1 Neat cement 2 Cement grout 3 Bentonite 4 Other  
Grout Intervals: From 6' ft. to 3' ft., From 6' ft. to 3' ft., From 6' ft. to 3' ft.  
What is the nearest source of possible contamination?  
1 Septic tank 4 Lateral lines 7 Pit privy 10 Livestock pens 14 Abandoned water well  
2 Sewer lines 5 Cess pool 8 Sewage lagoon 11 Fuel storage 15 Oil well/Gas well  
3 Watertight sewer lines 6 Seepage pit 9 Feedyard 12 Fertilizer storage 16 Other (specify below)  
13 Insecticide storage  
Direction from well? How many feet?

FROM	TO	LITHOLOGIC LOG	FROM	TO	PLUGGING INTERVALS
0	2.0	Black topped silt + clay			
2.0	22 1/2'	Moist, no clay lt. Red Brn silt to fine sand, w/ some coarse sand, etc.			
					Did not complete Terranext well connect to SVE system

7 CONTRACTOR'S OR LANDOWNER'S CERTIFICATION: This water well was (1) constructed (2) reconstructed, or (3) plugged under my jurisdiction and was completed on (mo/day/year) 3-24-98 and this record is true to the best of my knowledge and belief. Kansas Water Well Contractor's License No. 539 This Water Well Record was completed on (mo/day/yr) 4-8-98 under the business name of JB Environmental Drilling by (signature) James Buker

OFFICE USE ONLY  
T  
R  
EW  
SEC.