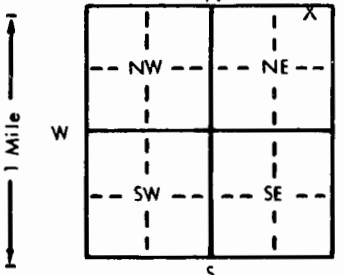


WATER WELL RECORD Form WWC-5 KSA 82a-1212

1 LOCATION OF WATER WELL: County: <u>Ellis</u>	Fraction <u>NE 1/4 NE 1/4 NE 1/4</u>	Section Number <u>10</u>	Township Number <u>T 14 S</u>	Range Number <u>R 18 XE/W</u>
---	---	-----------------------------	----------------------------------	----------------------------------

Distance and direction from nearest town or city street address of well if located within city?
From Hwy 40 and Canterbury Road 1 block south, 1 block west

2 WATER WELL OWNER: <u>William Rupp</u> RR#, St. Address, Box #: <u>1300 E. 19th</u> City, State, ZIP Code: <u>Hays, Kansas 67601</u>	Board of Agriculture, Division of Water Resources Application Number: <u>Upland</u>
---	--

3 LOCATE WELL'S LOCATION WITH AN "X" IN SECTION BOX: 	4 DEPTH OF COMPLETED WELL: <u>75</u> ft. ELEVATION: Depth(s) Groundwater Encountered 1. <u>65</u> ft. 2. <u>40</u> ft. 3. <u>7/15/98</u> ft. WELL'S STATIC WATER LEVEL <u>40</u> ft. below land surface measured on <u>mo/day/yr</u> <u>7/15/98</u> Pump test data: Well water was <u>40</u> ft. after <u>1</u> hours pumping <u>15</u> gpm Est. Yield <u>15</u> gpm: Well water was <u>40</u> ft. after <u>1</u> hours pumping <u>15</u> gpm Bore Hole Diameter: <u>10</u> in. to <u>75</u> ft., and <u>75</u> in. to <u>75</u> ft. WELL WATER TO BE USED AS: <u>1</u> Domestic <u>3</u> Feedlot <u>6</u> Oil field water supply <u>9</u> Dewatering <u>12</u> Other (Specify below) <u>2</u> Irrigation <u>4</u> Industrial <u>7</u> Lawn and garden only <u>10</u> Monitoring well Was a chemical/bacteriological sample submitted to Department? Yes <u>No</u> <u>X</u> ; If yes, mo/day/yr sample was submitted Water Well Disinfected? Yes <u>X</u> No
--	--

5 TYPE OF BLANK CASING USED: 1 Steel <u>2</u> 3 RMP (SR) 5 Wrought iron 8 Concrete tile <u>2</u> PVC 4 ABS 6 Asbestos-Cement 9 Other (specify below) Blank casing diameter <u>5</u> in. to <u>65</u> ft., Dia. <u>26</u> TYPE OF SCREEN OR PERFORATION MATERIAL: <u>7</u> <u>7</u> PVC 10 Asbestos-cement 1 Steel 3 Stainless steel 5 Fiberglass 8 RMP (SR) 11 Other (specify) 2 Brass 4 Galvanized steel 6 Concrete tile 9 ABS 12 None used (open hole) SCREEN OR PERFORATION OPENINGS ARE: <u>8</u> 5 Gauzed wrapped 8 Saw cut 11 None (open hole) 1 Continuous slot 3 Mill slot 6 Wire wrapped 9 Drilled holes 2 Louvered 
--

6 GROUT MATERIAL: <u>3</u> 1 Neat cement 2 Cement grout <u>3</u> Bentonite 4 Other Grout Intervals: From <u>0</u> ft. to <u>20</u> ft., From <u>20</u> ft. to <u>20</u> ft., From <u>20</u> ft. to <u>20</u> ft. What is the nearest source of possible contamination: <u>Gasoline</u> 1 Septic tank 4 Lateral lines 7 Pit privy 10 Livestock pens 14 Abandoned water well 2 Sewer lines 5 Cess pool 8 Sewage lagoon 11 Fuel storage 15 Oil well/Gas well 3 Watertight sewer lines 6 Seepage pit 9 Feedyard 12 Fertilizer storage 16 Other (specify below) 13 Insecticide storage Direction from well? <u>North</u> How many feet? <u>1300</u>

FROM	TO	LITHOLOGIC LOG	FROM	TO	PLUGGING INTERVALS
0	3	Topsoil			
3	41	Gumbo			
41	60	Coarse sand			
60	65	Gumbo			
65	70	Sand			
70	75	Shale			

7 CONTRACTOR'S OR LANDOWNER'S CERTIFICATION: This water well was (1) constructed, (2) reconstructed, or (3) plugged under my jurisdiction and was completed on (mo/day/year) <u>7/29/98</u> <u>7/15/98</u> and this record is true to the best of my knowledge and belief. Kansas Water Well Contractor's License No. <u>199</u> This Water Well Record was completed on (mo/day/yr) <u>7/29/98</u> under the business name of <u>Karst Water Well Drilling & Service, Inc.</u> by (signature) <u>[Signature]</u>

INSTRUCTIONS: Use typewriter or ball point pen. PLEASE PRESS FIRMLY and PRINT clearly. Please fill in blanks, underline or circle the correct answers. Send top three copies to Kansas Department of Health and Environment, Bureau of Water, Topeka, Kansas 66620-0001. Telephone: 913-296-5545. Send one to WATER WELL OWNER and retain one for your records.

OFFICE USE ONLY
T
R
EW
SEC.